


T. 4S. R. 1W. W.M.

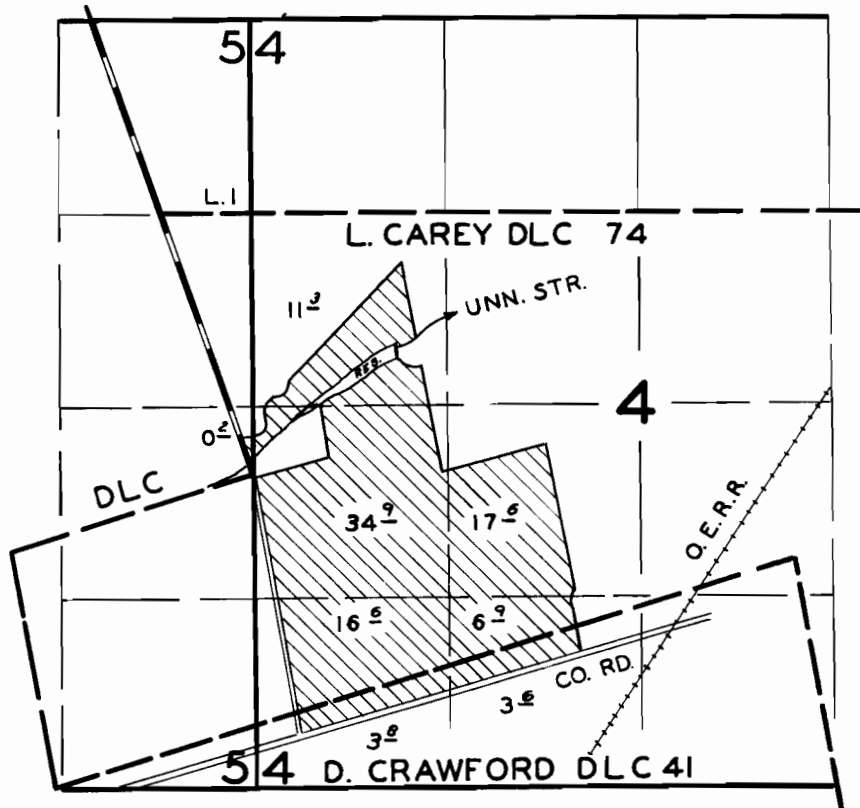

FINAL PROOF SURVEY UNDER

Application No. 32446..... Permit No. 25623.....
IN NAME OF

..... W. & RICHARD RACETTE

Surveyed MAY 24... 19 60, by G.O. BARTELS.....