


T.6 S.R.1 E.W.M.

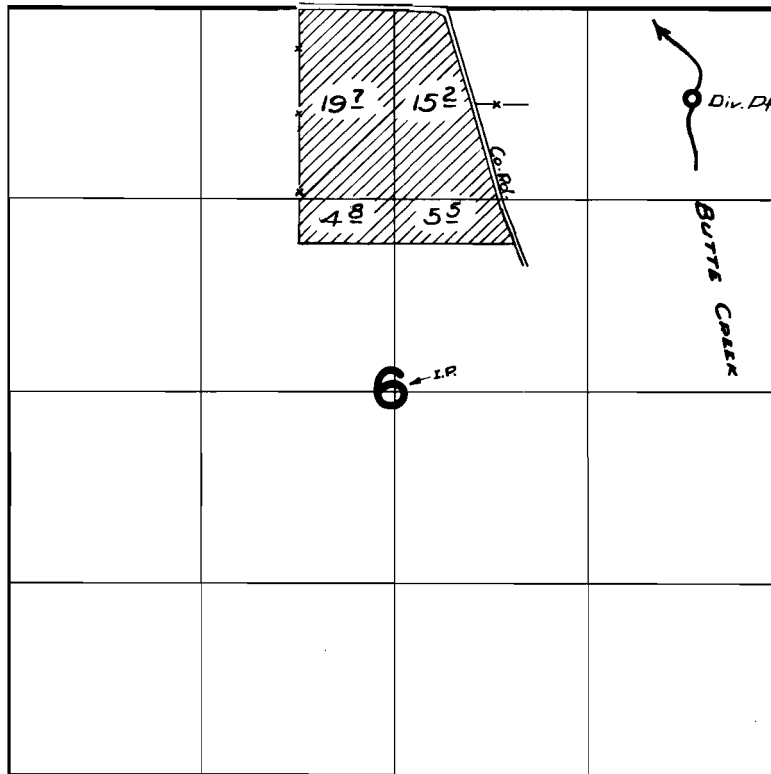

FINAL PROOF SURVEY UNDER

Application No. 32927 Permit No. 26022
IN NAME OF

REX ROSS

Surveyed 19 April 1960, by Mr. Bish