


T. I. S. R. 4E. W.M.

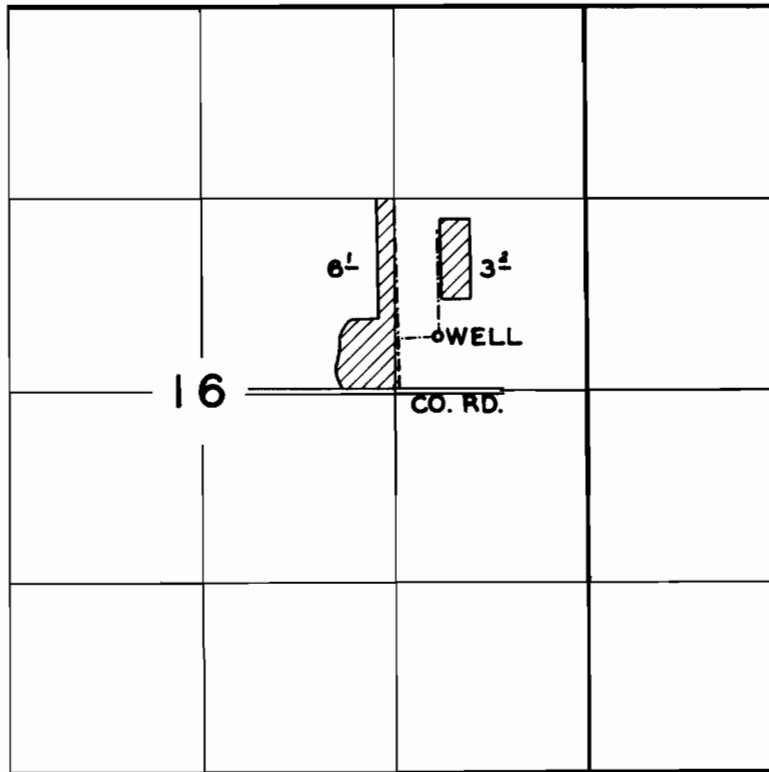

FINAL PROOF SURVEY UNDER

Application No. G.265 Permit No. G.202
IN NAME OF

ANDREW WILLIAM & ANNE SHERWOOD

Surveyed MAY 9 1960, by C. O. BARTELS