


T. 1 N. R. 3 E. W.M.

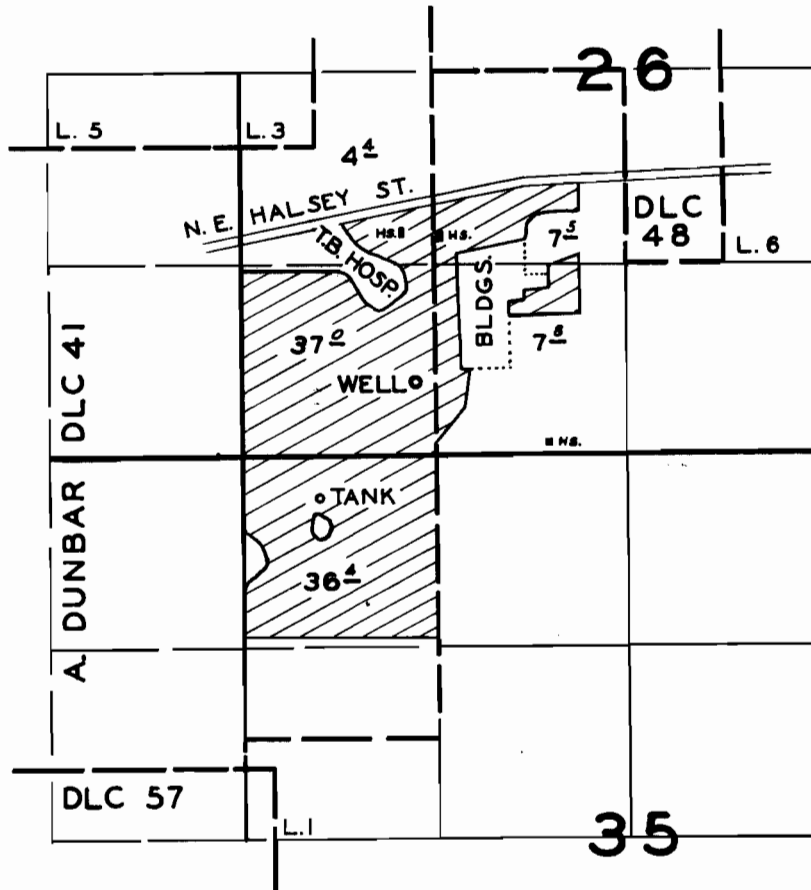

FINAL PROOF SURVEY
UNDER

Application No. G 1275 Permit No. G 1183

IN NAME OF

MULTNOMAH COUNTY
BOARD OF COMMISSIONERS

Surveyed MAY 12 1960, by C. O. BARTELS