


T. IS. R. 3E. W.M.

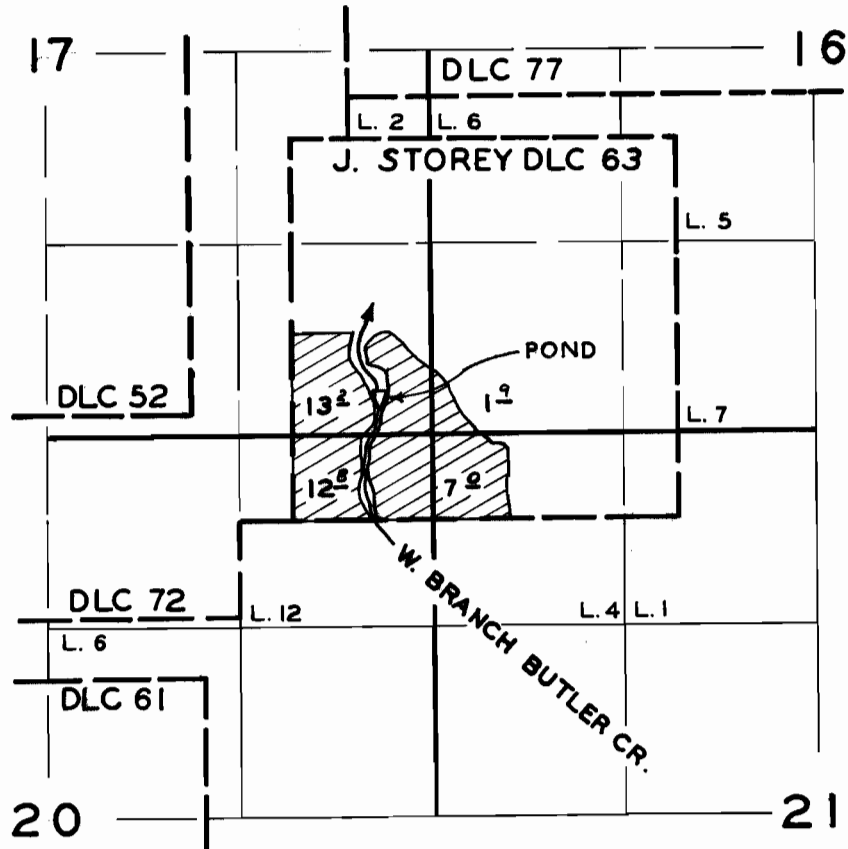

FINAL PROOF SURVEY UNDER

Application No. 29230 Permit No. 23074
IN NAME OF

KAZUO FUJII

Surveyed MAY 10 1960, by C.O. BARTELS