


# T. IS. R. 3E. W.M.

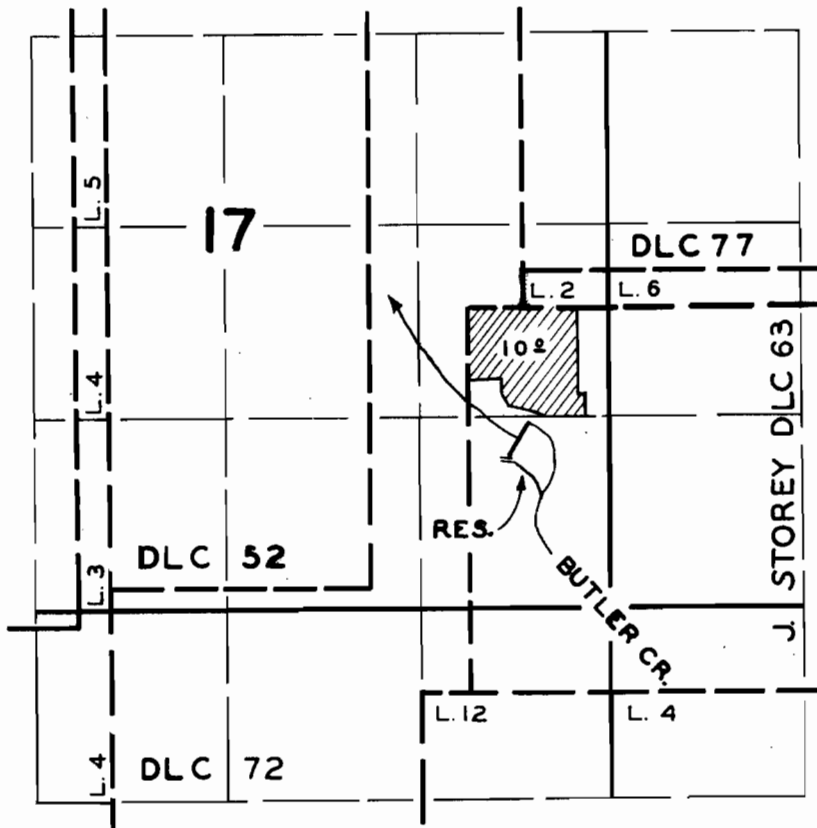

## FINAL PROOF SURVEY UNDER

Application No. R 29206 29207 Permit No. R1745 23569  
IN NAME OF

PAUL PEYRALANS

Surveyed JUNE 5 19 59 MAY 10 19 60, by C. O. BARTELS