


T. IS. R. 3E. W.M.

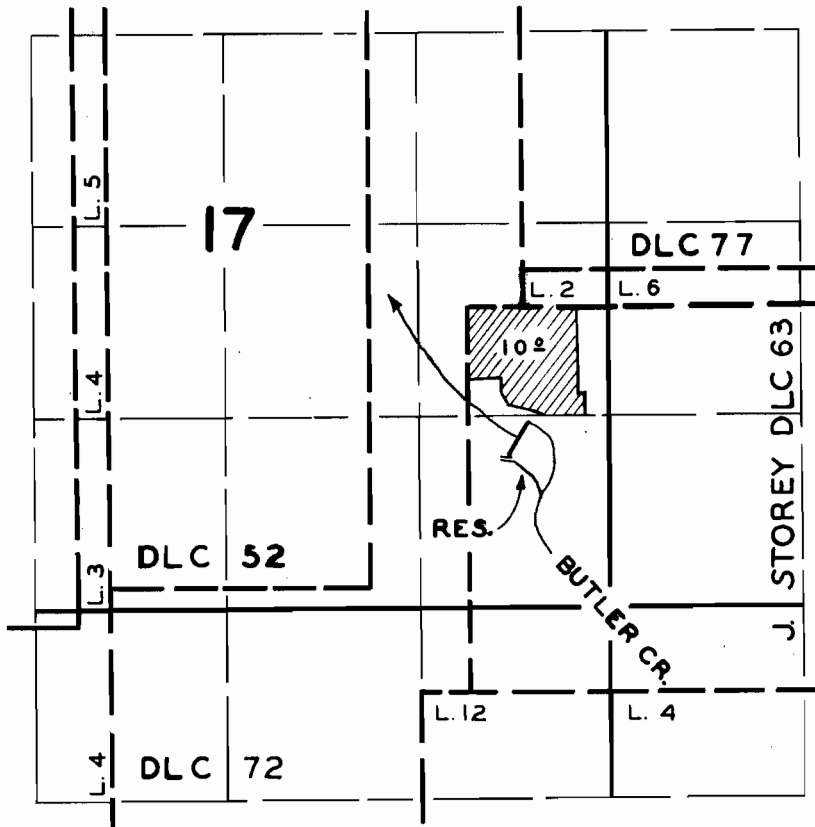

FINAL PROOF SURVEY UNDER

Application No. R 29206 29207 Permit No. R1745 23569
IN NAME OF

PAUL PEYRALANS

Surveyed JUNE 5 1959
MAY 10 1960⁵⁹ by C. O. BARTELS