


T. IN. R. IW. W.M.

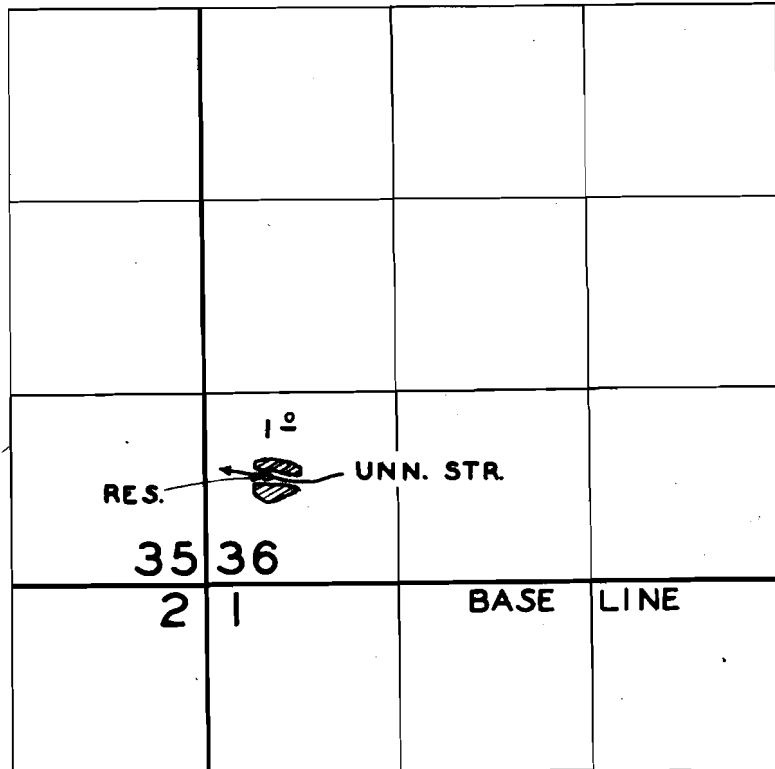

FINAL PROOF SURVEY UNDER

Application No. R30225
30226 Permit No. R1991
24713
IN NAME OF

WADE & FRANCES STROWGER

Surveyed JULY 6, 1960, by C. O. BARTELS