


T.6-7S. R.6W.W.M.

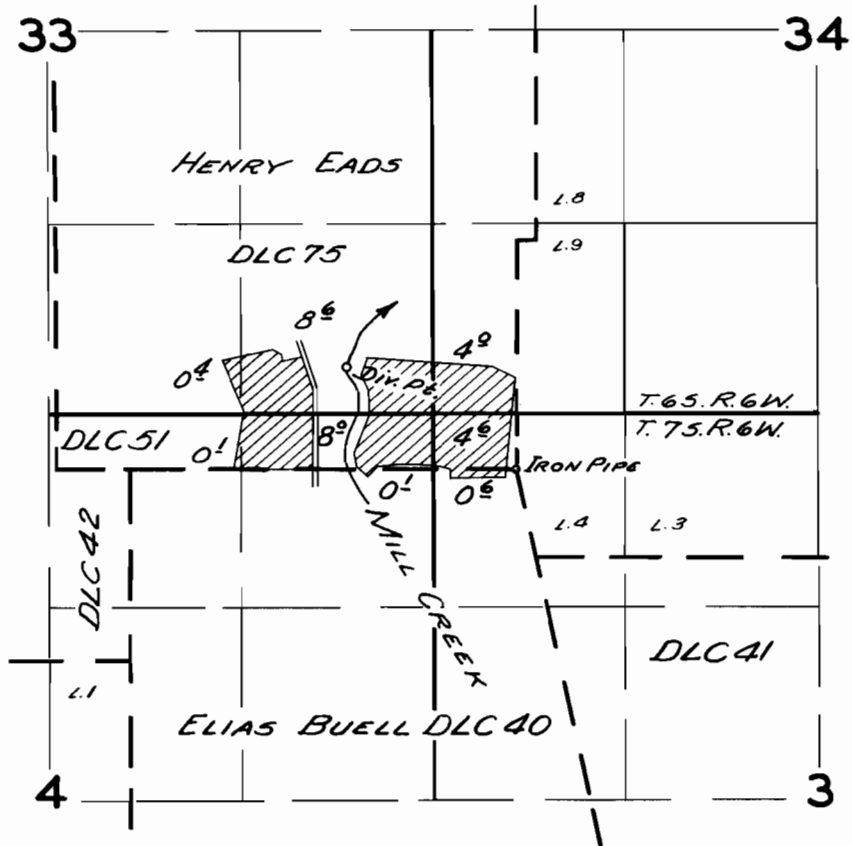

**FINAL PROOF SURVEY**  
UNDER

Application No. 30088... Permit No. 23711...  
IN NAME OF

..... *HUGH H. WALKER* .....

Surveyed *June 23 1960*, by *C.D. Baileto*.....