


T.6S. R.4W.W.M.

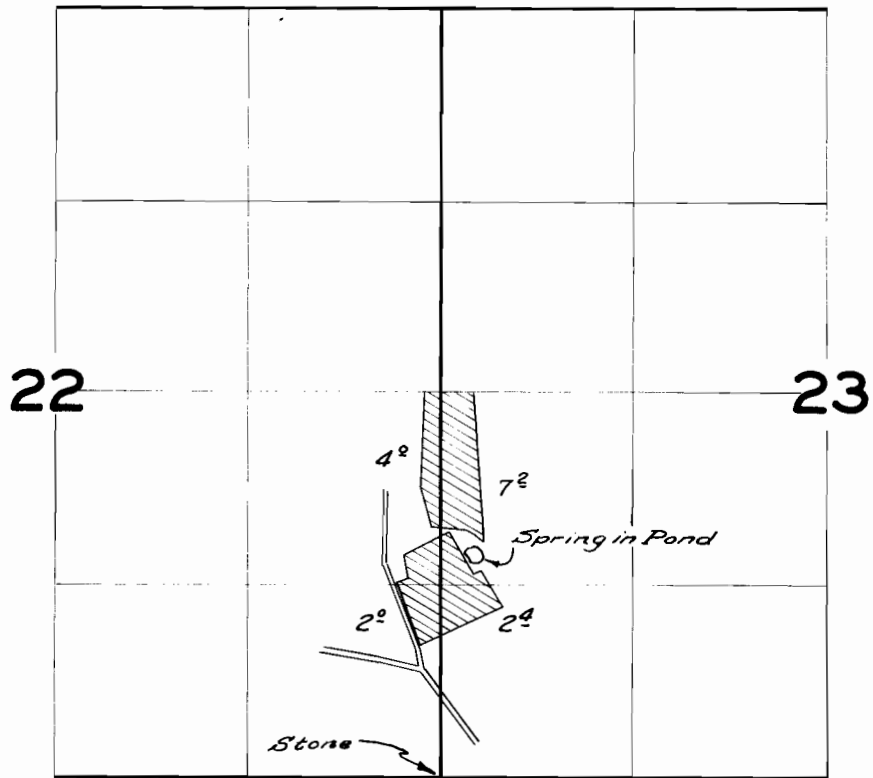

FINAL PROOF SURVEY  
UNDER

Application No. 31399... Permit No. 24752...  
IN NAME OF

*ERNEST SOLLE*

Surveyed June 20, 1960, by *C.O. Butts*