


# T.6N. R.3 5E.W.M.

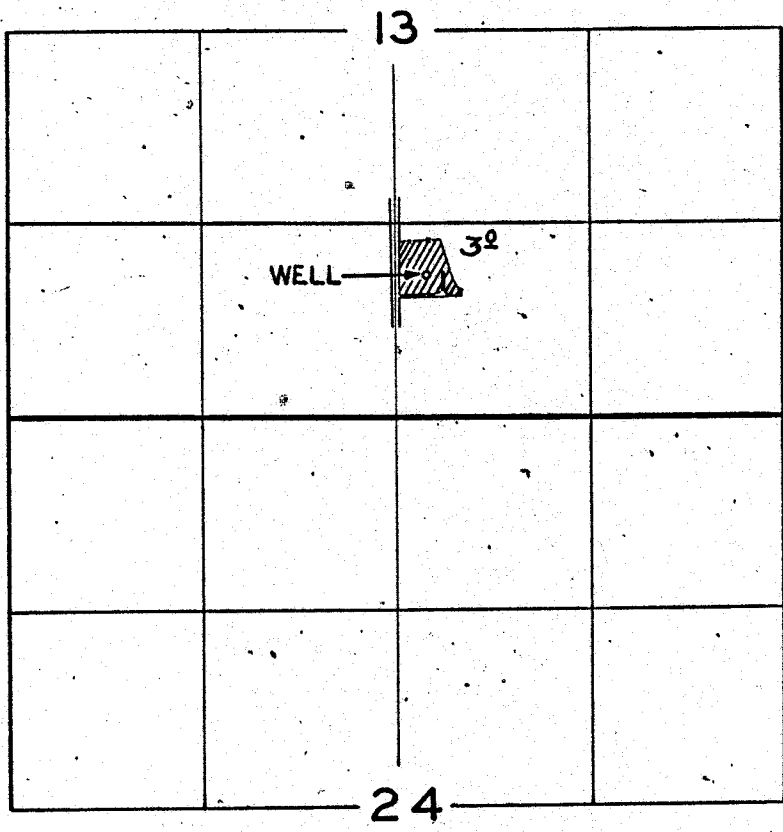

## FINAL PROOF SURVEY UNDER

Application No. U-611 Permit No. U-608  
IN NAME OF

HENRY KAYE

Surveyed JULY 12 1960, by M. BISH