


T.6N. R.34E.W.M.

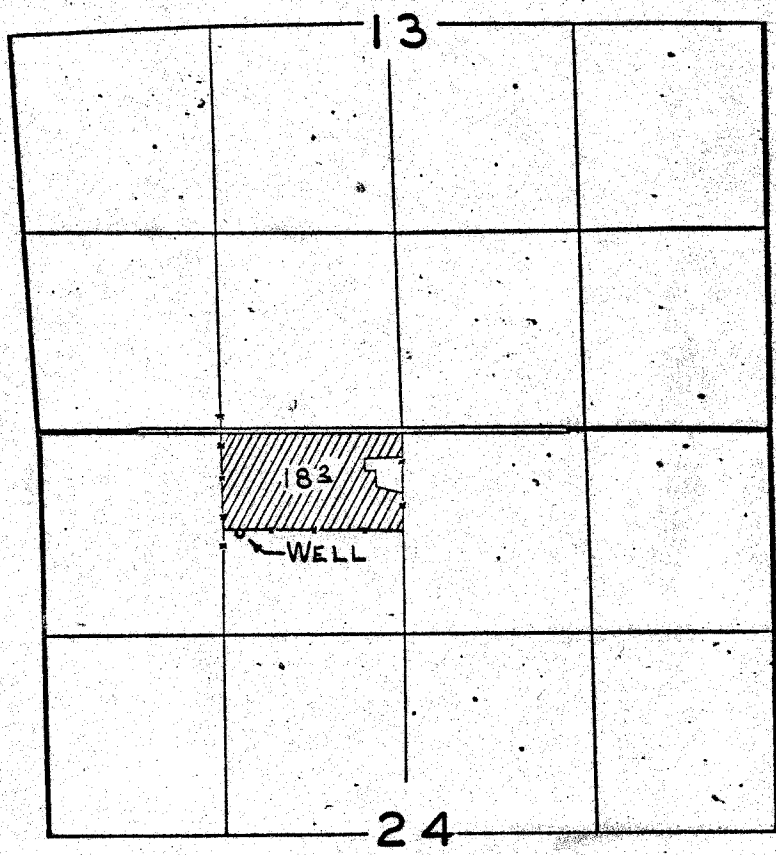

FINAL PROOF SURVEY UNDER

Application No. G1631... Permit No. G1008...
IN NAME OF

.....JOHN L. RICHARTZ.....

Surveyed JULY 16, 1960, by M. BISH.....