


# T.6N. R.35E.W.M.

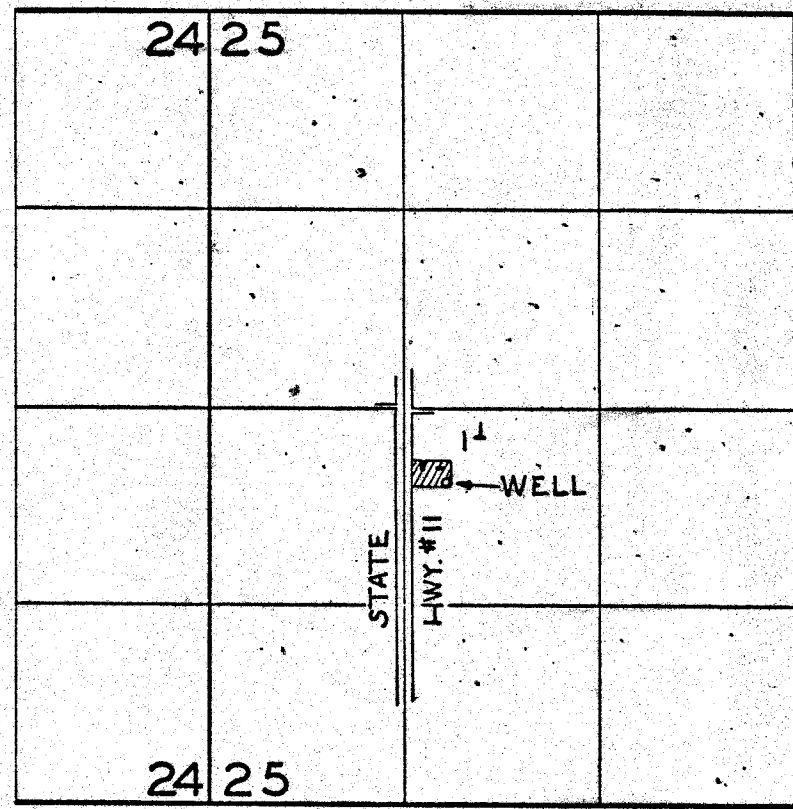

## FINAL PROOF SURVEY UNDER

Application No. G-535 Permit No. G-444  
IN NAME OF

WILLIAM M. & ENID B. COMFORT

Surveyed JULY 12 1960, by M. BISH