


T. 1 S. R. 39 E. W. M.

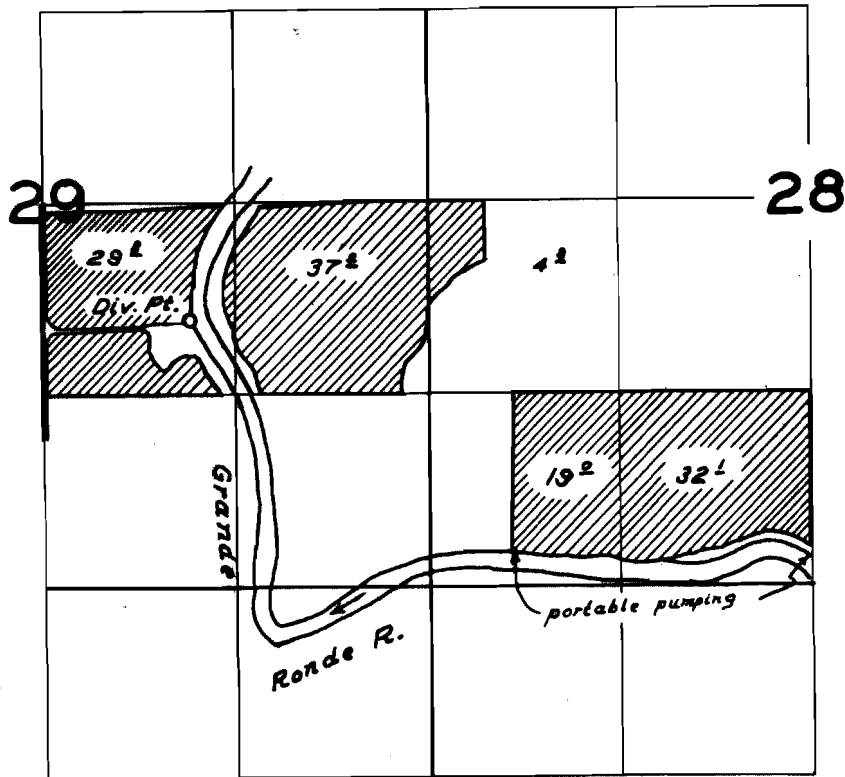

void


FINAL PROOF SURVEY
UNDER

Application No. 30375 Permit No. 24435
IN NAME OF

Oscar W. Howell

Surveyed Aug. 7, 1959, by R.H. Jackson.

T. 1 S. R. 39 E. W. M.

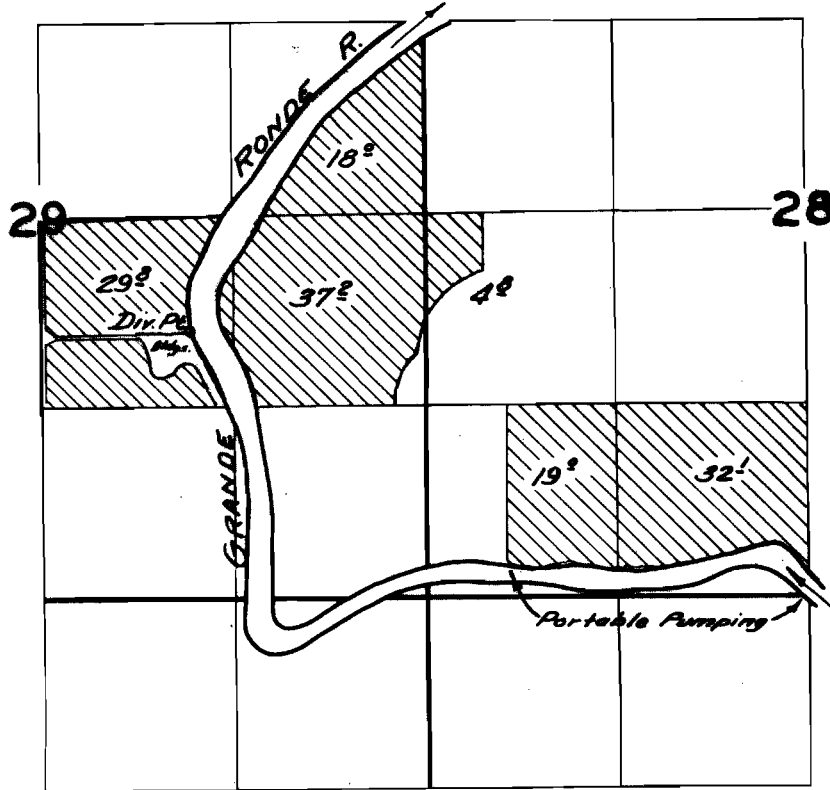

FINAL PROOF SURVEY UNDER

Application No. *30375*... Permit No. *24435*...
IN NAME OF

OSCAR W. HONELL

Surveyed *Acres*... *7*... 19*59*, by *R.H. JACKSON*
JUNE 14 1960 by *C.O. BARTELS*