


G 38
~~G 241~~

T.1N.&1S. R.13E.W.M.

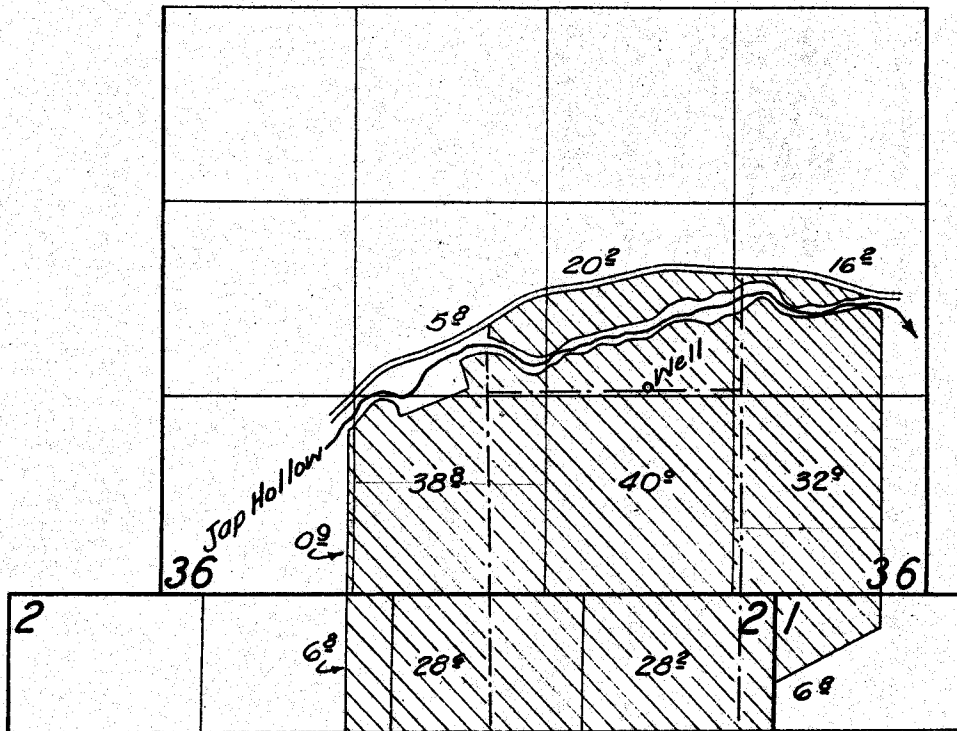

FINAL PROOF SURVEY

UNDER

Application No. G-134 G-406 Permit No. G-38 G-281

IN NAME OF

William G. Dick

Surveyed Nov. 13, 1959, by C.O. Baute