


G 38
~~G 241~~

T. 1 N. & 1 S. R. 13 E. W.M.

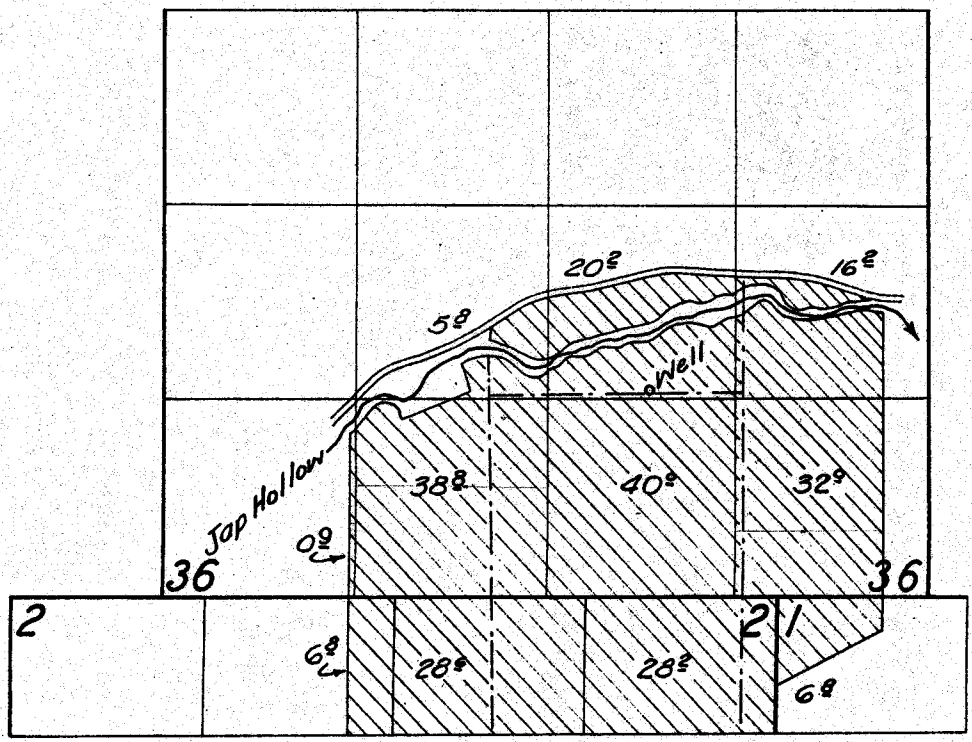

FINAL PROOF SURVEY

UNDER

Application No. G-134 Permit No. G-38
~~G-406~~ ~~G-281~~

IN NAME OF

William G. Dick

Surveyed Nov. 13, 1959, by C.O. Baitle