


T. 1 S. R. 1 E. & W. W. M.

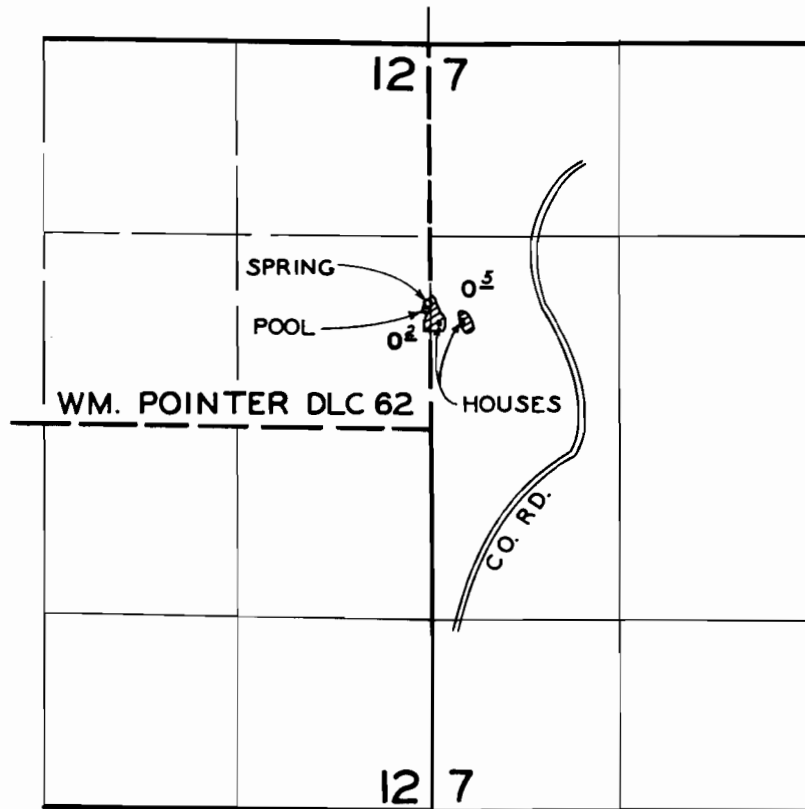

FINAL PROOF SURVEY UNDER

Application No. 30705 Permit No. 24409
IN NAME OF

E. FAYE & ALLISON H. DEAN

Surveyed JULY 7, 1960, by C. O. BARTELS