


T.5 S.R.6W.W.M.

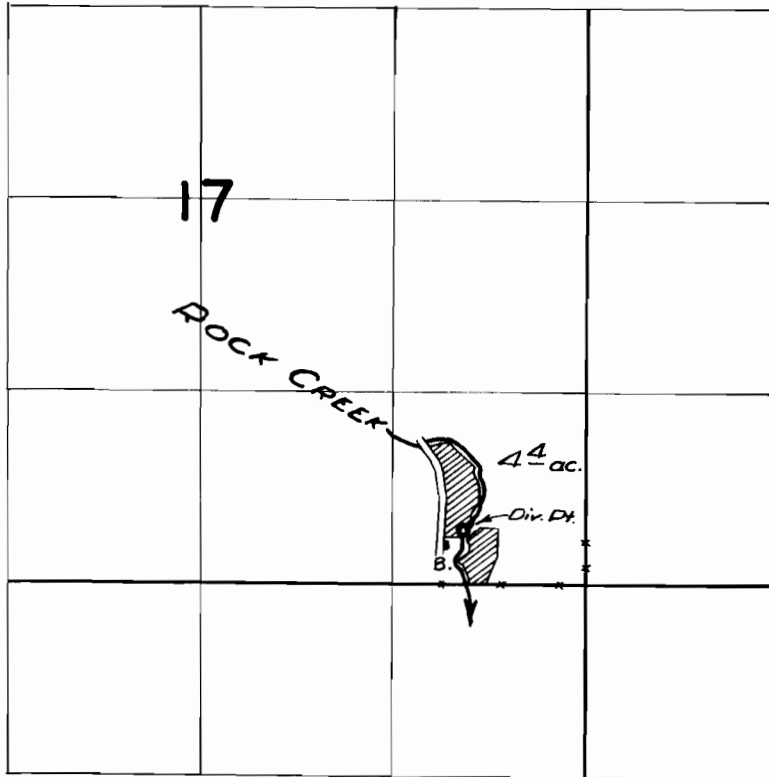

FINAL PROOF SURVEY
UNDER

Application No. 27142 Permit No. 21349
IN NAME OF

NOAH A. WRIGHT

Surveyed 19 MAY 1960, by M. B. Bish