


T.4 S.R.5 W.W.M.

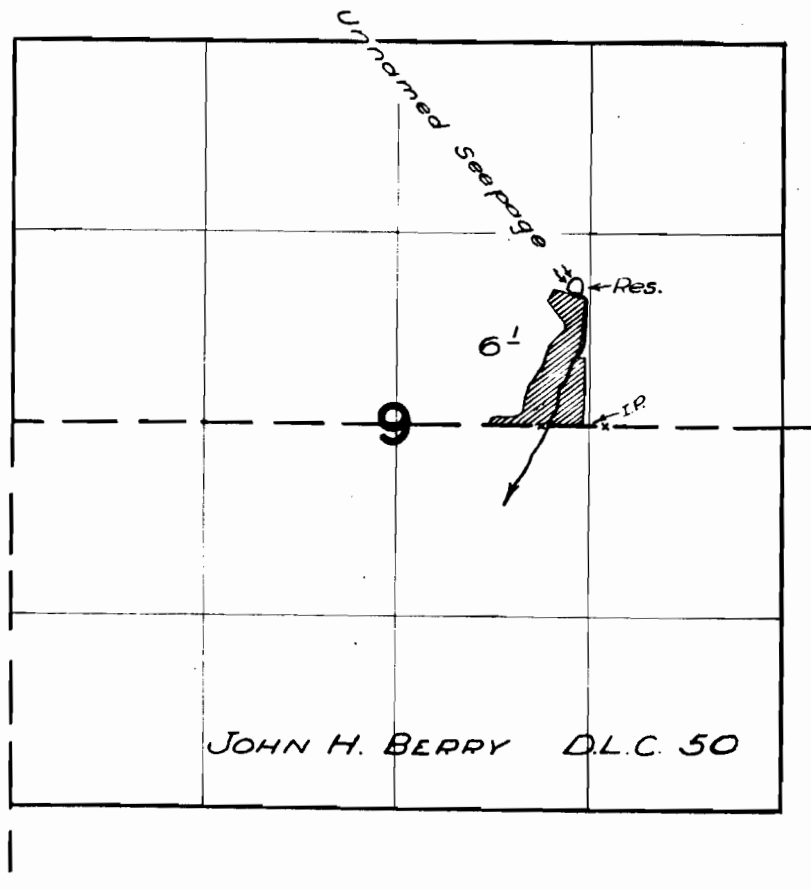

FINAL PROOF SURVEY
UNDER

30062 23940
Application No. P-3006 / Permit No. P-1814
IN NAME OF

CHARLES ALBERT & MONA V. ENGLE

Surveyed 23 MAY 1960 by M. Bish