


T.4 S.R.5 W.W.M.

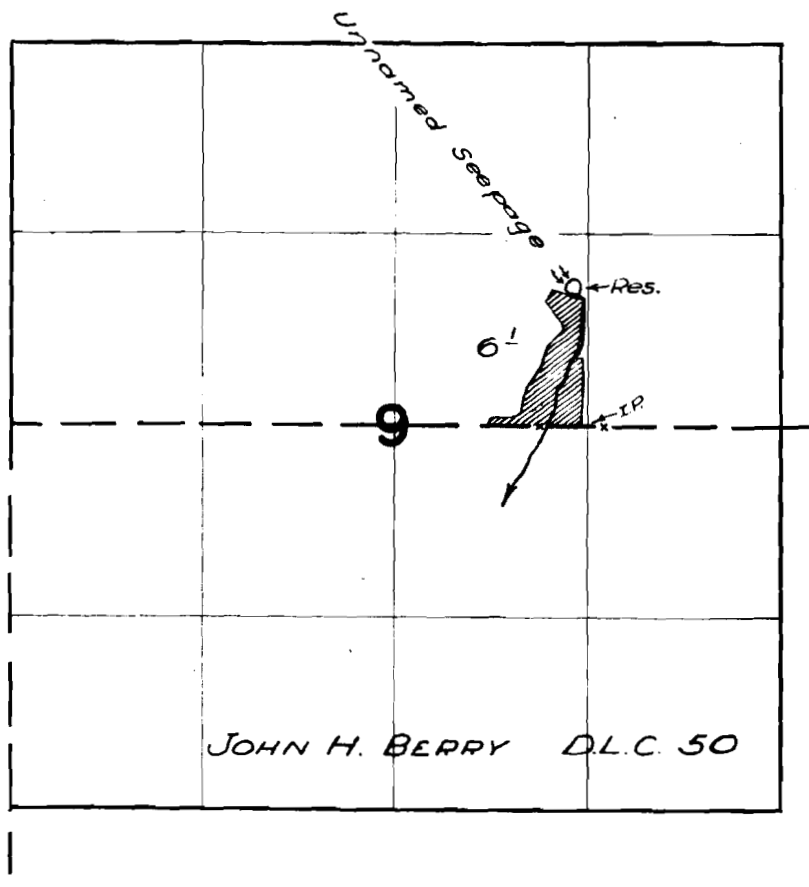

FINAL PROOF SURVEY
UNDER

Application No. 30062 / Permit No. 23940
IN NAME OF

CHARLES ALBERT & MONA V ENGLE

Surveyed 23 MAY 1960, by M. Bish