


T.2 S.R.3 W.W.M.

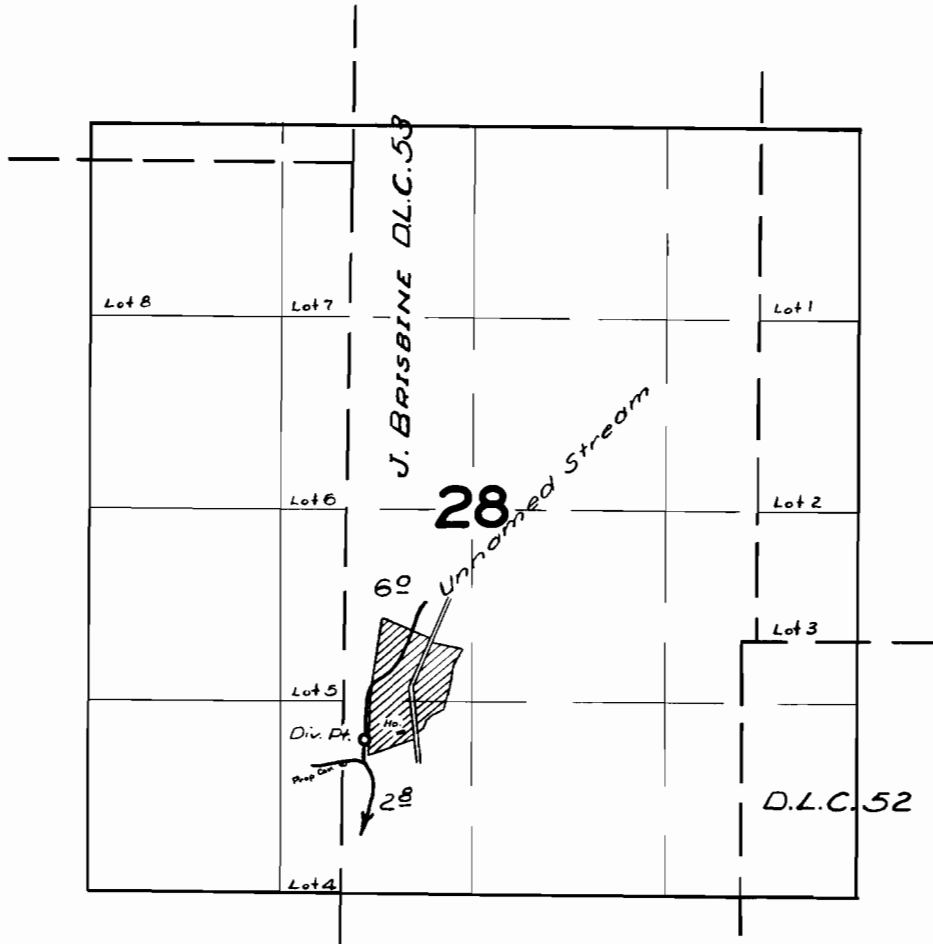

FINAL PROOF SURVEY
UNDER

Application No. 30611 Permit No. 24117
IN NAME OF

EDISON N. SMITH

Surveyed 26 MAY 1960, by m. Bish