


T.5S.R.7 W.W.M.

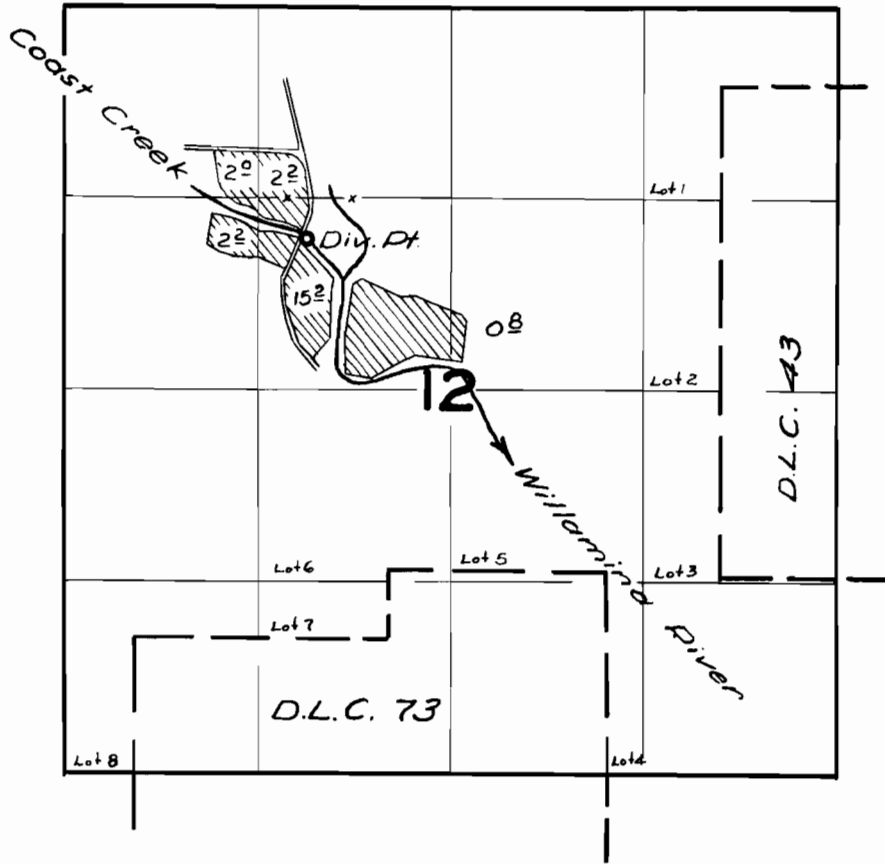

**FINAL PROOF SURVEY**  
UNDER

Application No. 30655 Permit No. 24145  
IN NAME OF

K.V. DRAKE

Surveyed 19 MAY 1960 by M. Bish