


T.4 S.R.4 W.W.M.

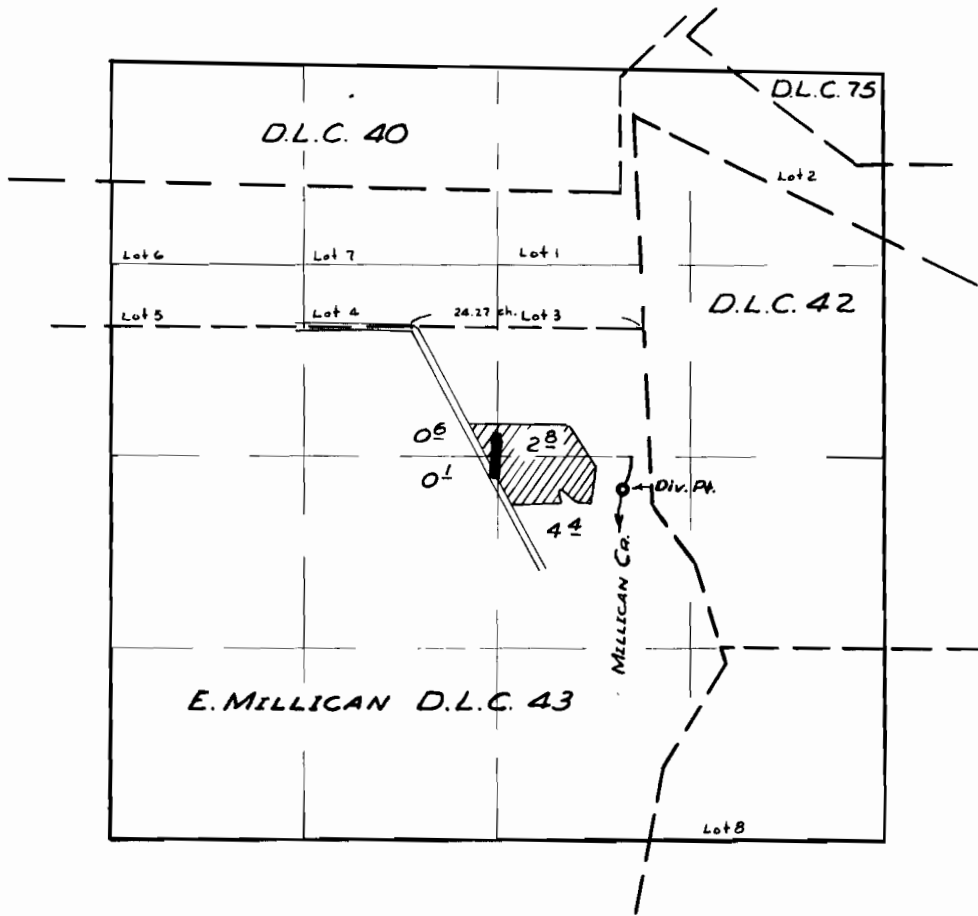

FINAL PROOF SURVEY UNDER

Application No. 30972 Permit No. 24357
IN NAME OF

M.E. ERICKSON

Surveyed 27 MAY 1960, by Tom B. Bick