


T.3 S.R.2 W.W.M.

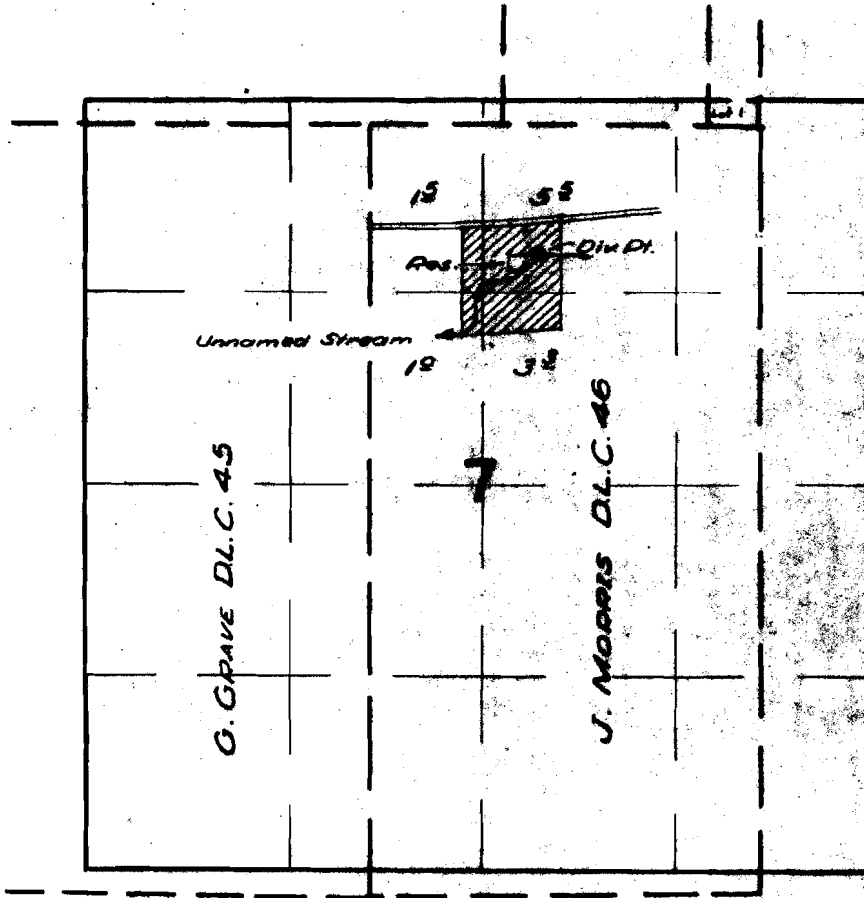

FINAL PROOF SURVEY UNDER

Application No. 31086 Permit No. 24467
R-31085 R-1979
IN NAME OF

WALTER C. ADERS

Surveyed 25 MAY 1900 by W. C. Aders