


T.3 S.R.2 W.W.M.

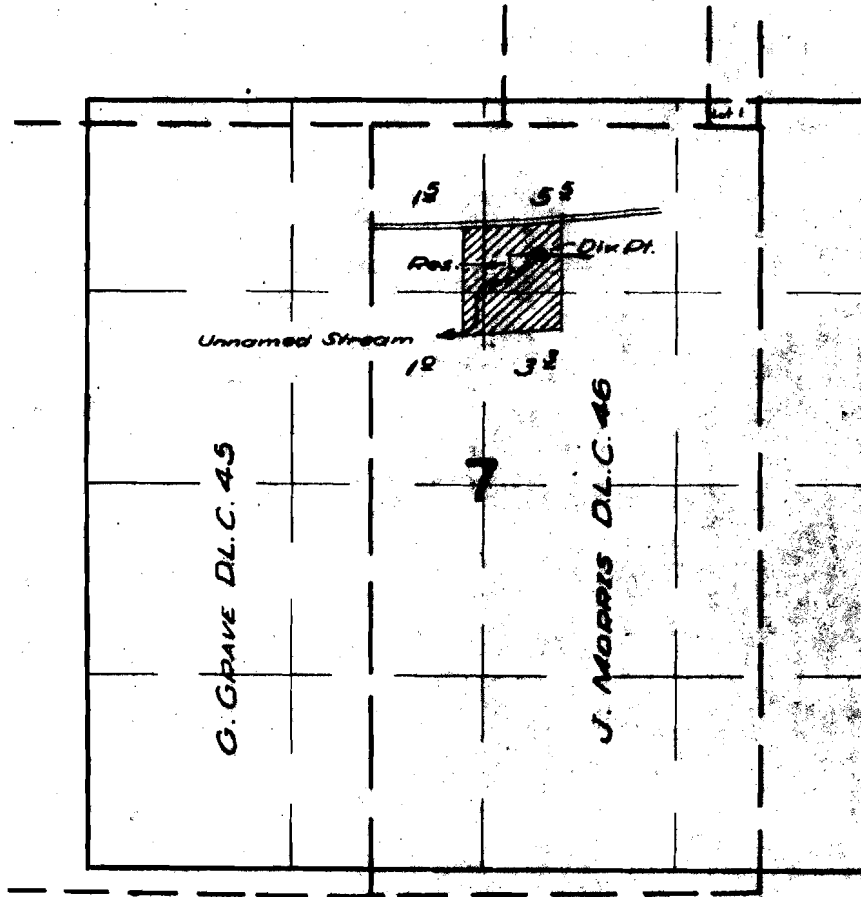

**FINAL PROOF SURVEY**  
UNDER

Application No. 31086 Permit No. 24467  
P-31085 P-1929  
IN NAME OF

WALTER C. ADERS

Surveyed 25 MAY 1900 by W. C. Aders