


T. 4 S.R. 4 W.W.M.

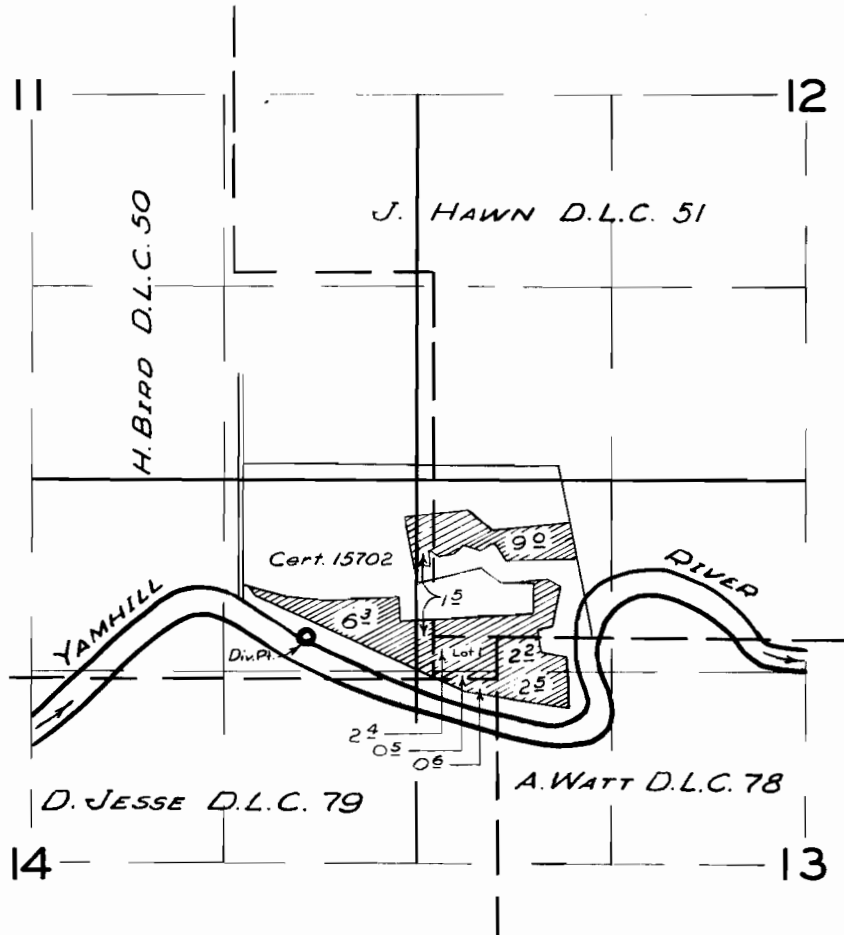

FINAL PROOF SURVEY UNDER

Application No. 32168 Permit No. 25379
IN NAME OF

STANLEY MALOTT

Surveyed 27 MAY 1960, by m. Bish