


T.5S.R.3 W.W.M.

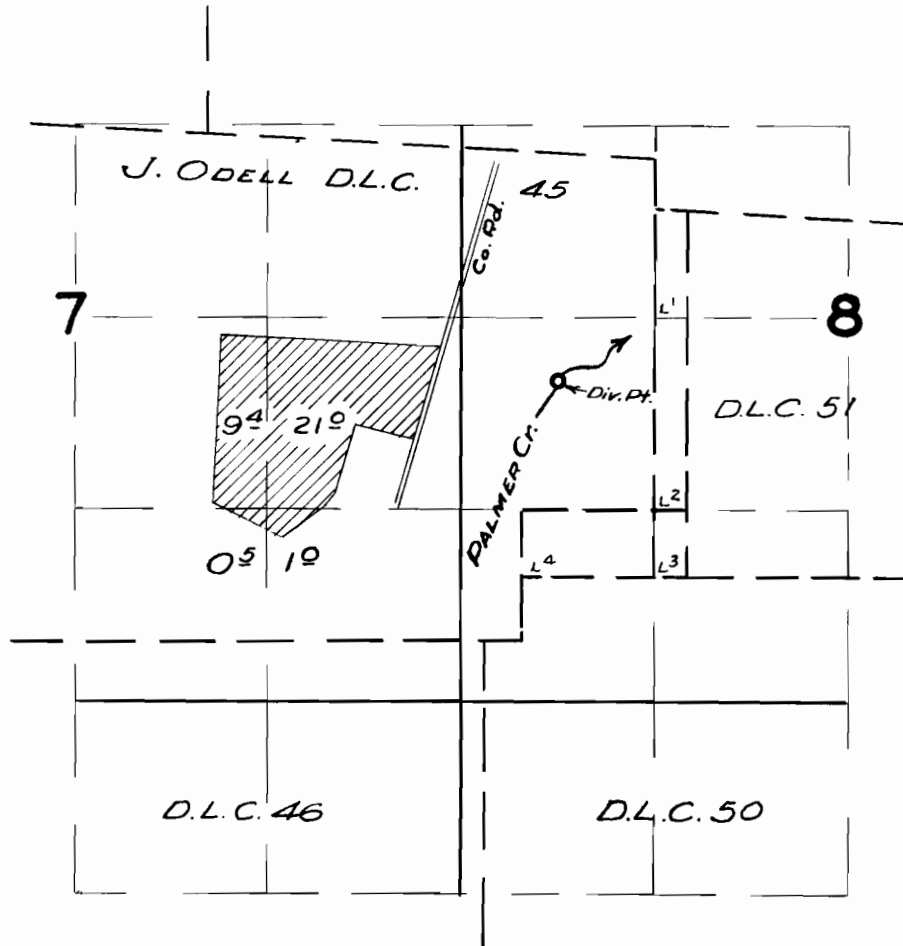

FINAL PROOF SURVEY UNDER

Application No. 32215 Permit No. 25418
IN NAME OF

CHARLEY CARR

Surveyed 2 JUNE 1960, by me B. Rich