


T.5 S.R.4 W.W.M.

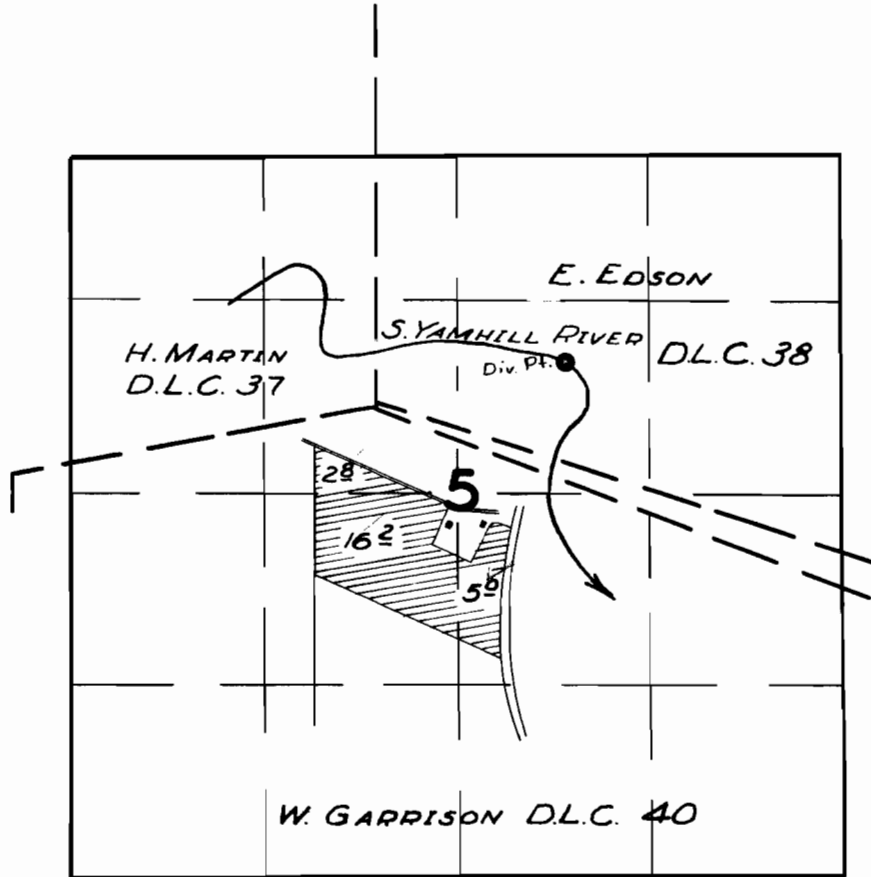

FINAL PROOF SURVEY
UNDER

Application No. 32873 Permit No. 25963
IN NAME OF

LYLE TRESHAM

Surveyed 16 May 1960 by M. B. Bish