


# T.4 S.R.3 W.W.M.

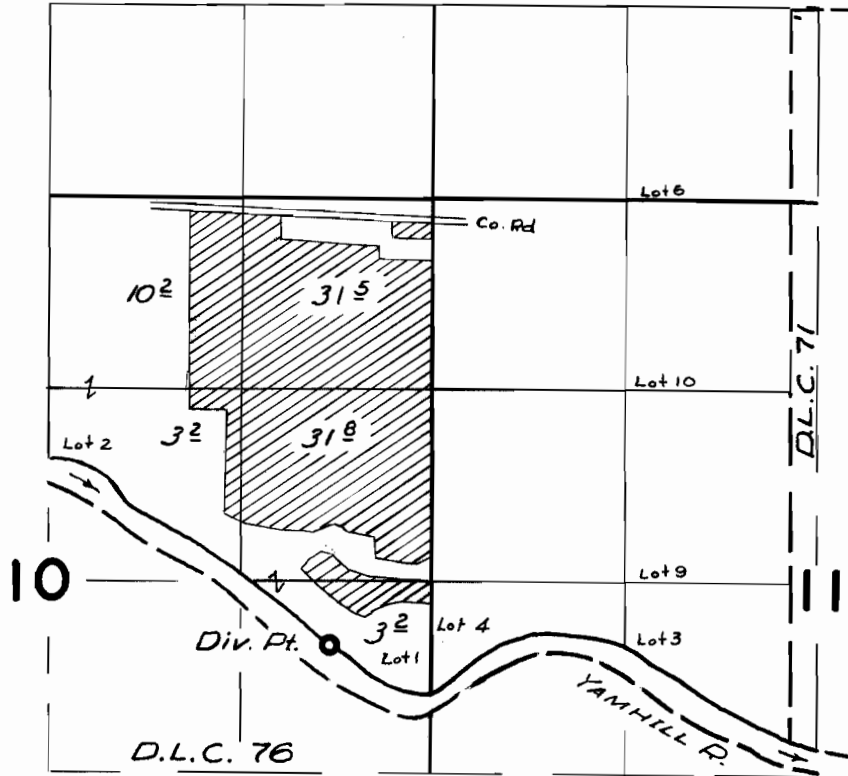

## FINAL PROOF SURVEY UNDER

Application No. 33009 Permit No. 26099  
IN NAME OF

ROY W. DUNDAS

Surveyed 3 JUNE 1960, by M. Bush