


T.3-4 S. R.1 E. W. M.

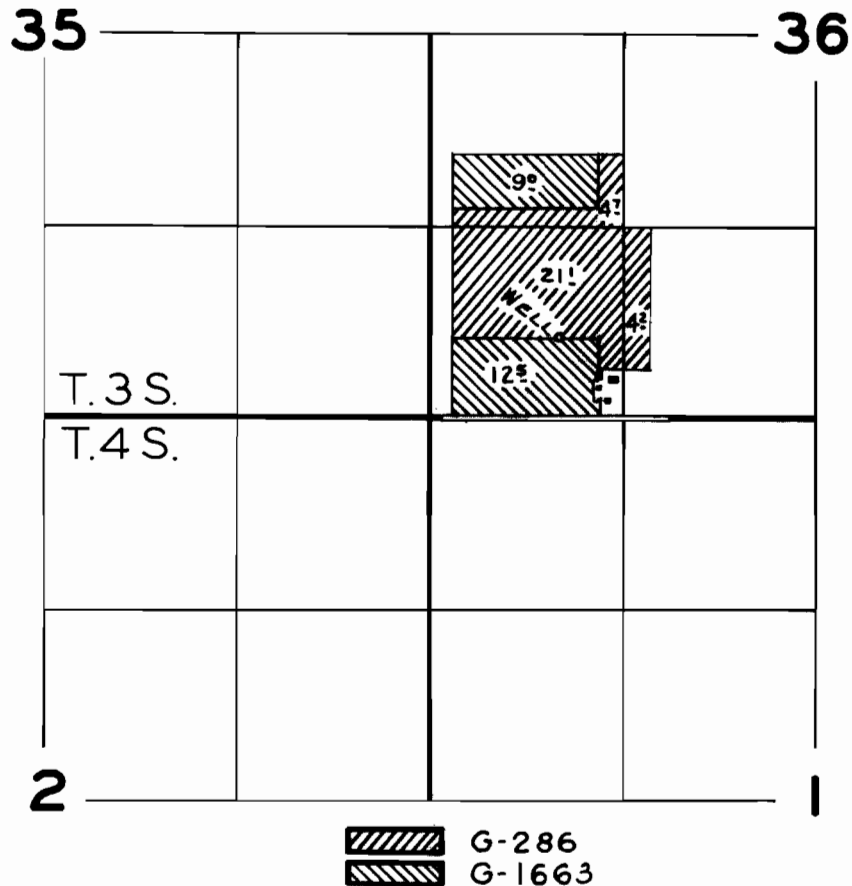

FINAL PROOF SURVEY
UNDER

Application No. ^{G-286}~~G-1663~~ Permit No. ^{G-193}~~G-1523~~
IN NAME OF

JOE DEMSHER, JR.

Surveyed Mar. 31, 1960, by W. Jackson