


T.3-4 S. R.1 E. W. M.

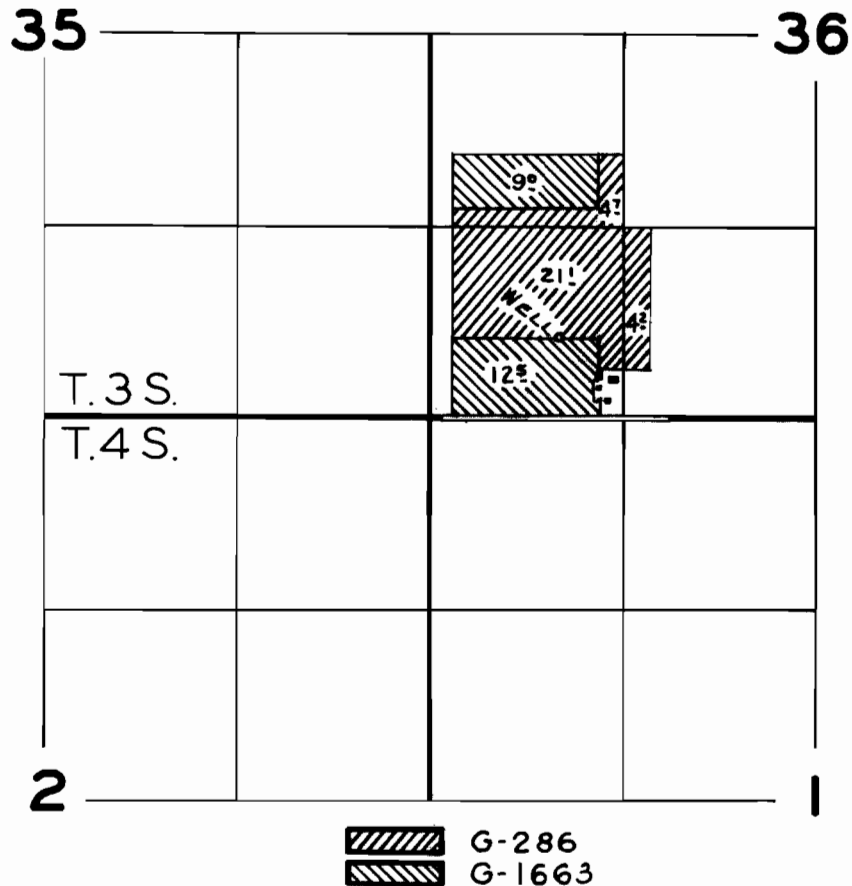

FINAL PROOF SURVEY
UNDER

Application No. ~~G-1663~~ ^{G-286} Permit No. ~~G-1523~~ ^{G-193}
IN NAME OF

JOE DEMSHER, JR.

Surveyed Mar. 31, 1960, by R. Jackson