


T.3S. R. 3E.W.M.

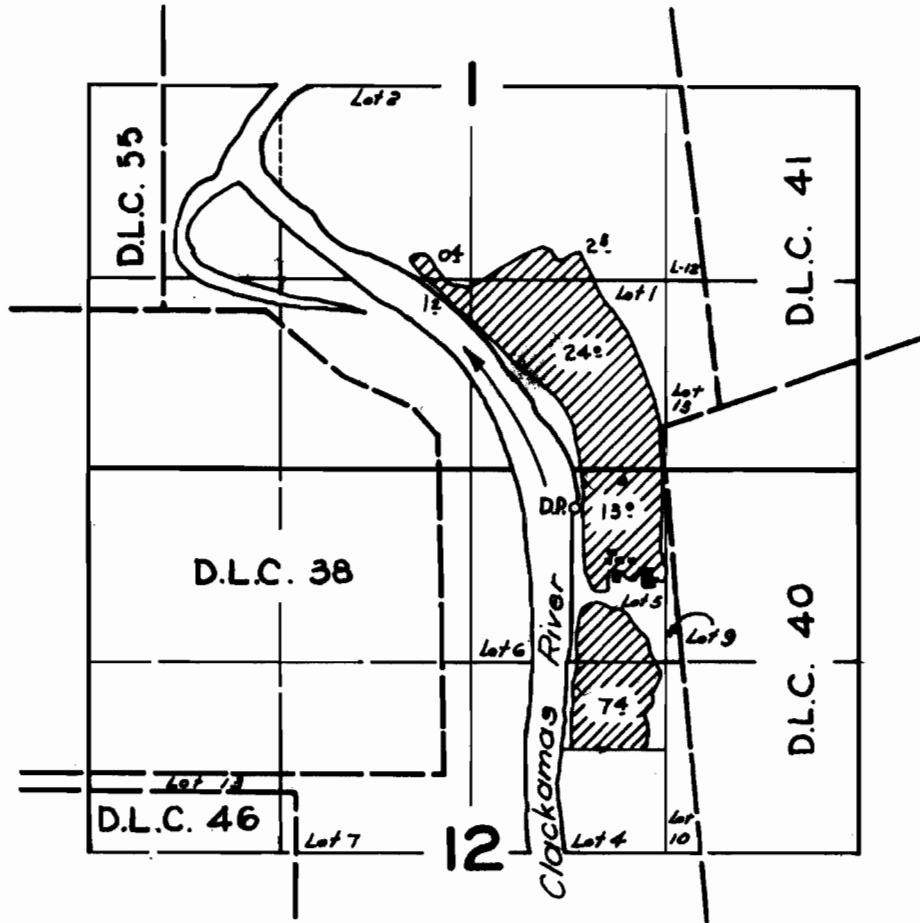

FINAL PROOF SURVEY
UNDER

Application No. 24671... Permit No. 19482...
IN NAME OF

JAMES O. COFFIELD

Surveyed 22 April, 1960, by *R.H. Jackson*