


T. 3 S. R. 5 E. W. M.

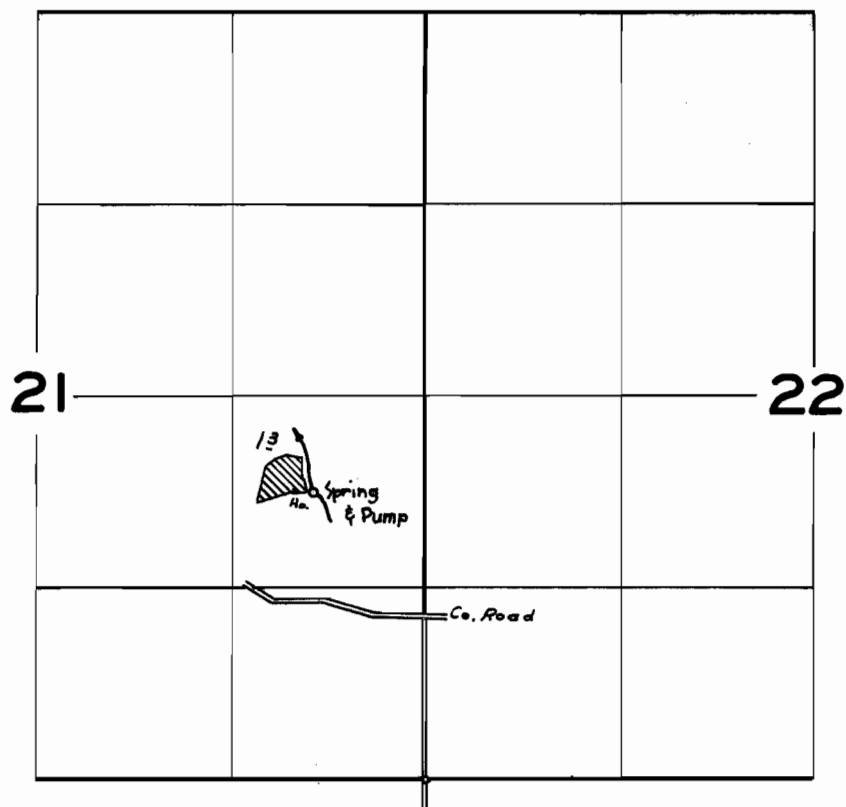

FINAL PROOF SURVEY
UNDER

Application No. 25239 Permit No. 19964
IN NAME OF

EDWIN & IRIS CORNWELL - DAVID & IRENE FAWKES

Surveyed Mar. 30 1960, by *El Jackson*