


T. 2 S. R. 3 E. W. M.

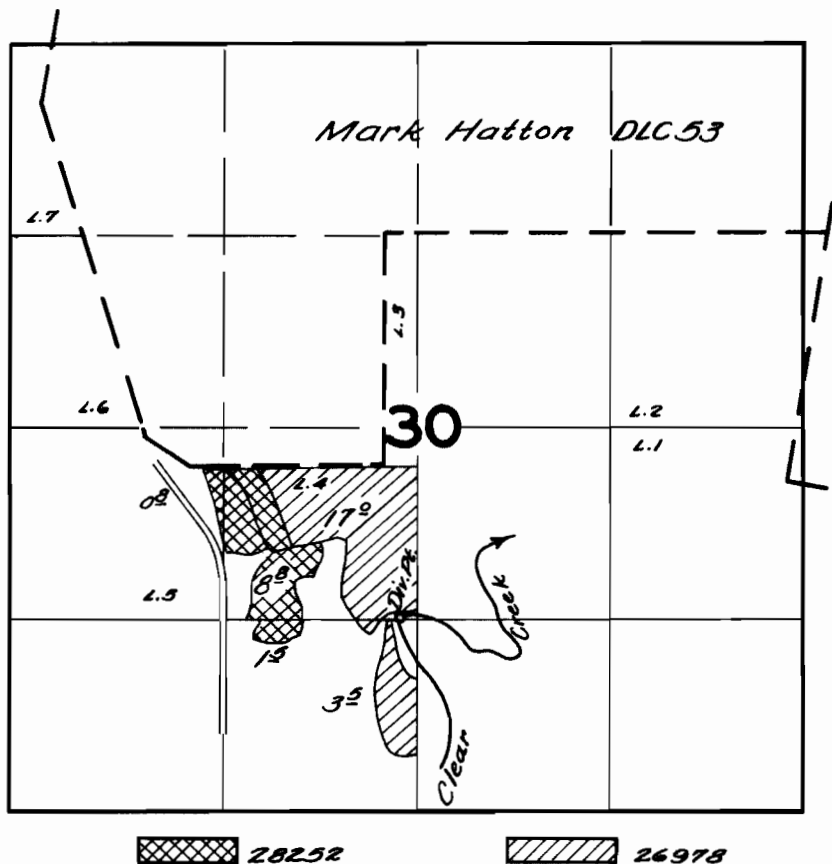

FINAL PROOF SURVEY UNDER

Application No. ²⁸²⁵² ~~26978~~ Permit No. ²²²¹⁷ ~~21191~~
IN NAME OF

..... *Paul E. Scheeff*

Surveyed *June 28 1960*, by *R. H. Whitley*