


T. 2 S. R. 3 E. W. M.

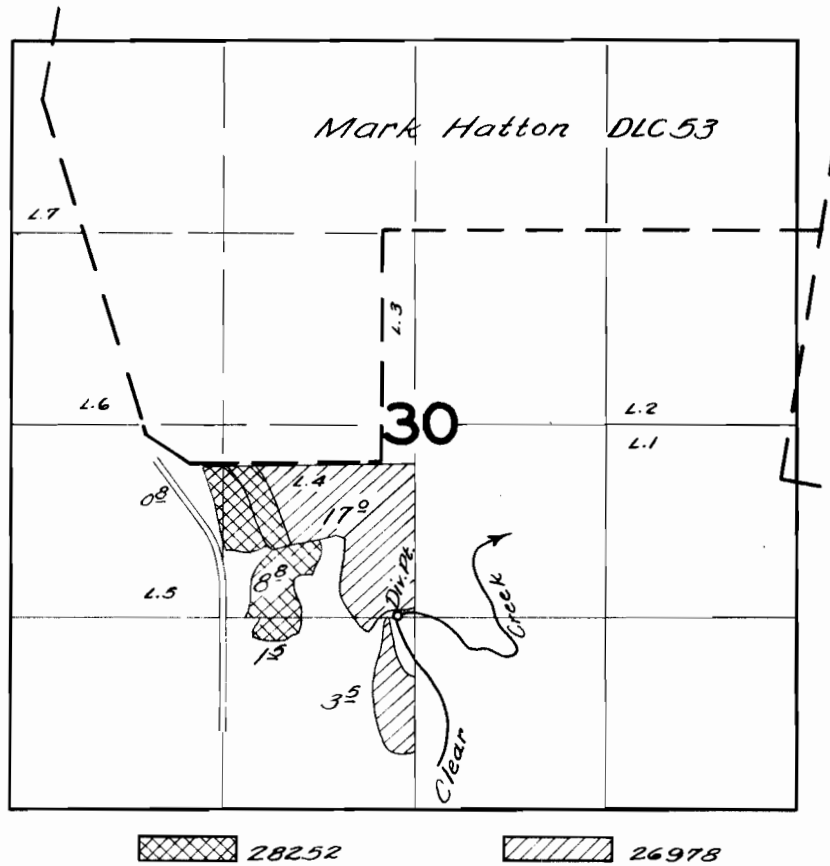

FINAL PROOF SURVEY UNDER

Application No. ²⁸²⁵² 26978 Permit No. ²²²¹⁷ 21191
IN NAME OF

Paul E. Scheeff

Surveyed *June 28 1960*, by *R. H. Whitley*