


T.2S. R 1E.W.M.

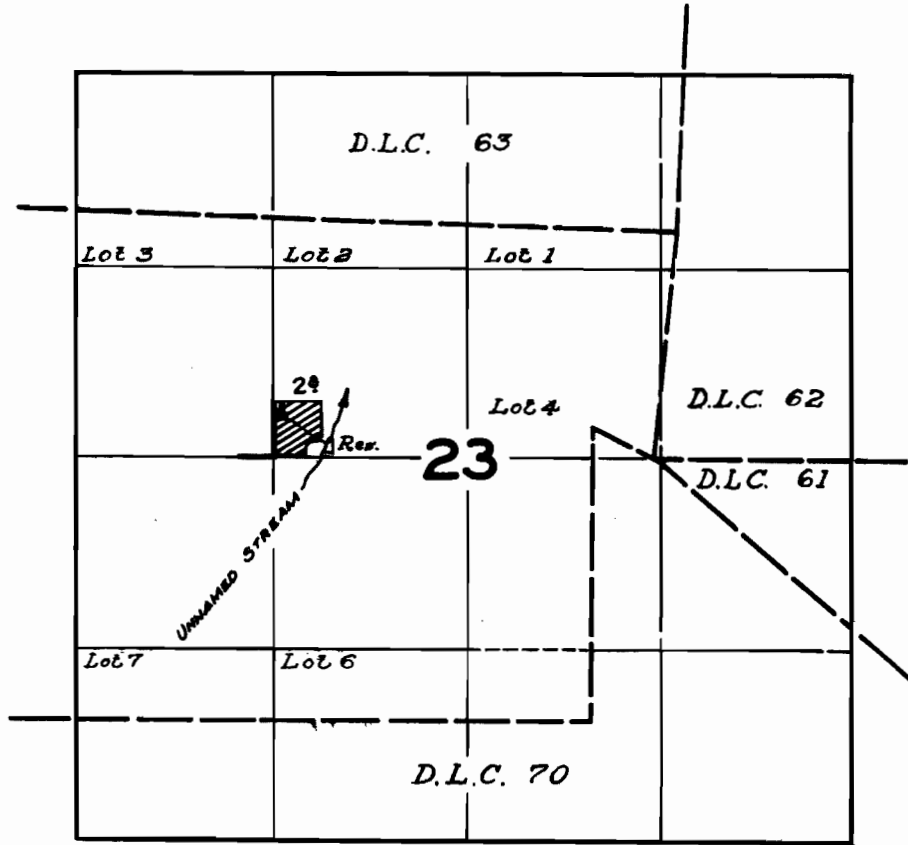

FINAL PROOF SURVEY UNDER

R-26846 R-1513
Application No. 26847... Permit No. 22418.....
IN NAME OF

CARL F. TRAPP

Surveyed April 26, 1960, by R. H. Jackson