


# T.2S.R 1E.W.M.

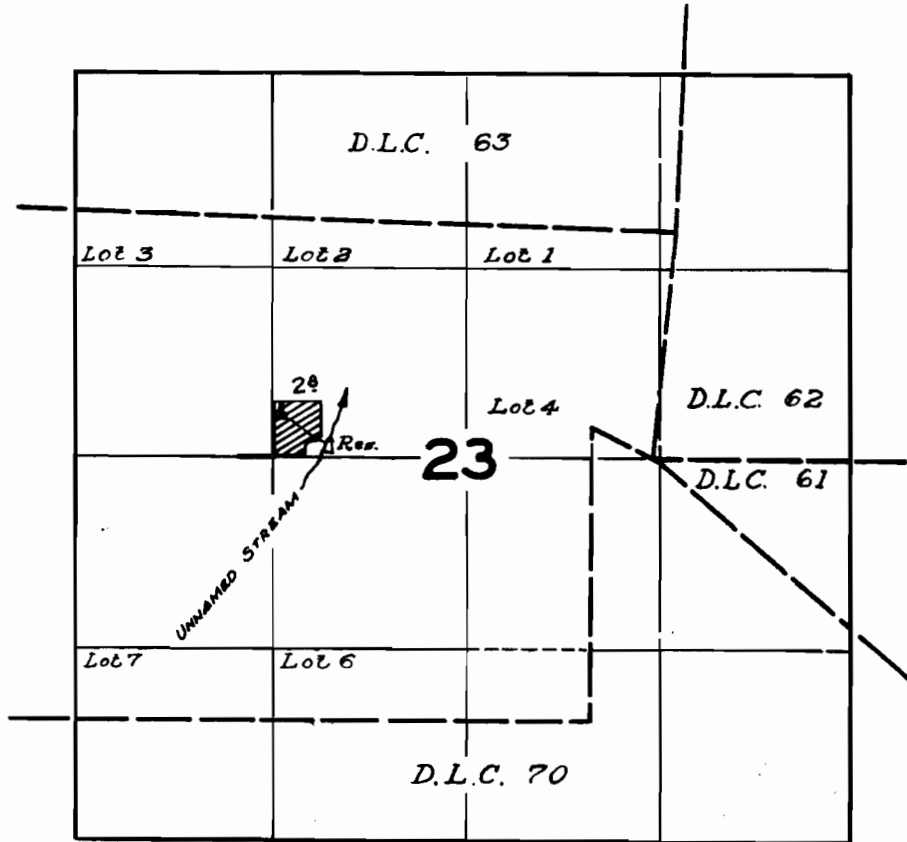

## FINAL PROOF SURVEY UNDER

R-26846 R-1513  
Application No. 26847... Permit No. 22418.....  
IN NAME OF

**CARL F. TRAPP**

Surveyed April 26, 1960, by *R. H. Jackson*