


T. 2S. R. 1E.W.M.

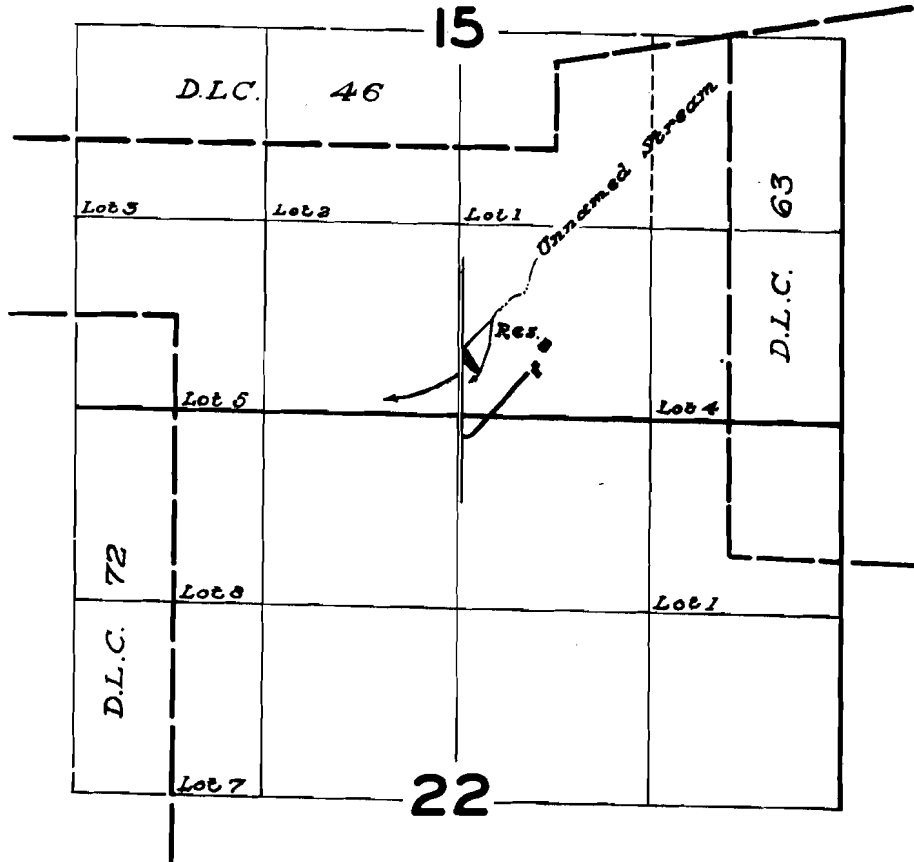

FINAL PROOF SURVEY  
UNDER

Application No. <sup>R-31942</sup> 31943 Permit No. <sup>R-2087</sup> 25184  
IN NAME OF

CLARENCE V. HODGES

Surveyed April 26 1960, by *R. J. Jackson*