


T. 2S. R. 1E.W.M.

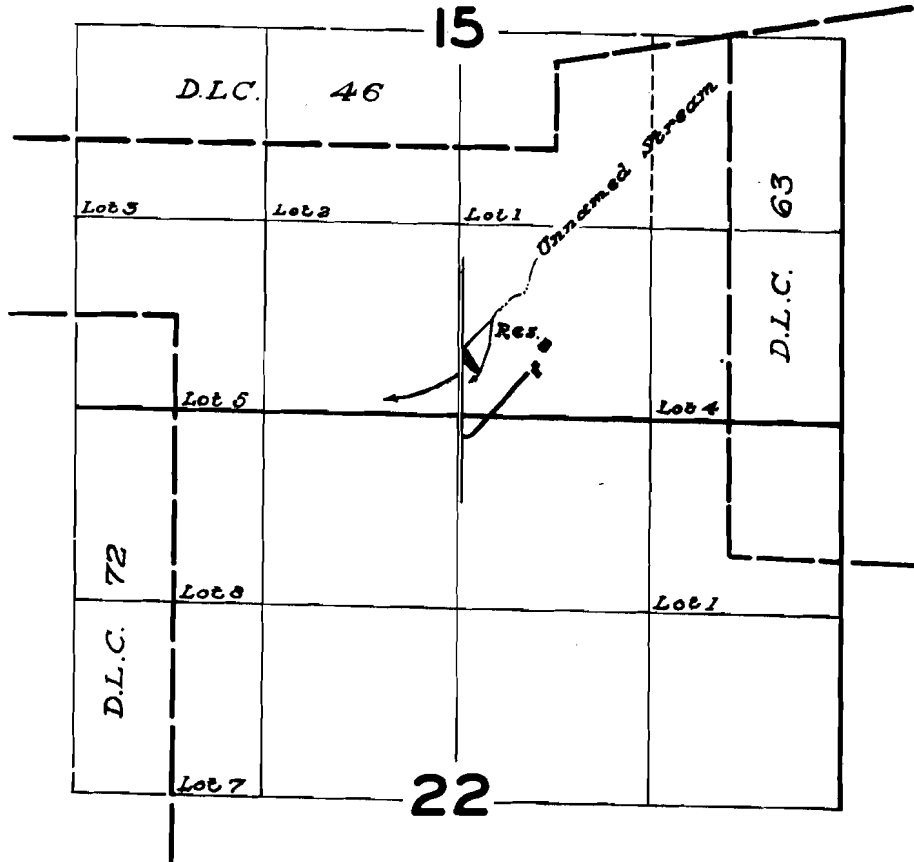

FINAL PROOF SURVEY
UNDER

Application No. ^{R-31942} 31943 Permit No. ^{R-2087} 25184
IN NAME OF

CLARENCE V. HODGES

Surveyed April 26 1960, by *R. J. Jackson*