


T.2S.R.4 E.W.M.

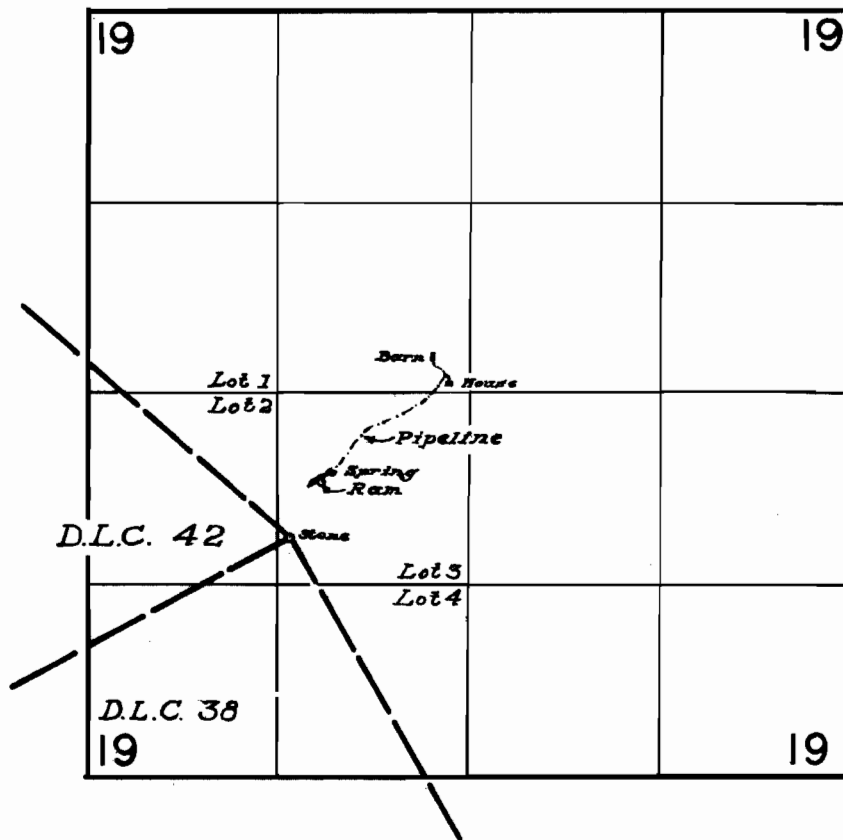

**FINAL PROOF SURVEY**  
UNDER

Application No. 29.908 Permit No. 23755  
IN NAME OF

SILAS R. VERMILYEA

Surveyed April 29 1960, by R. Jackson