


T. 3S. R. 1W.W.M.

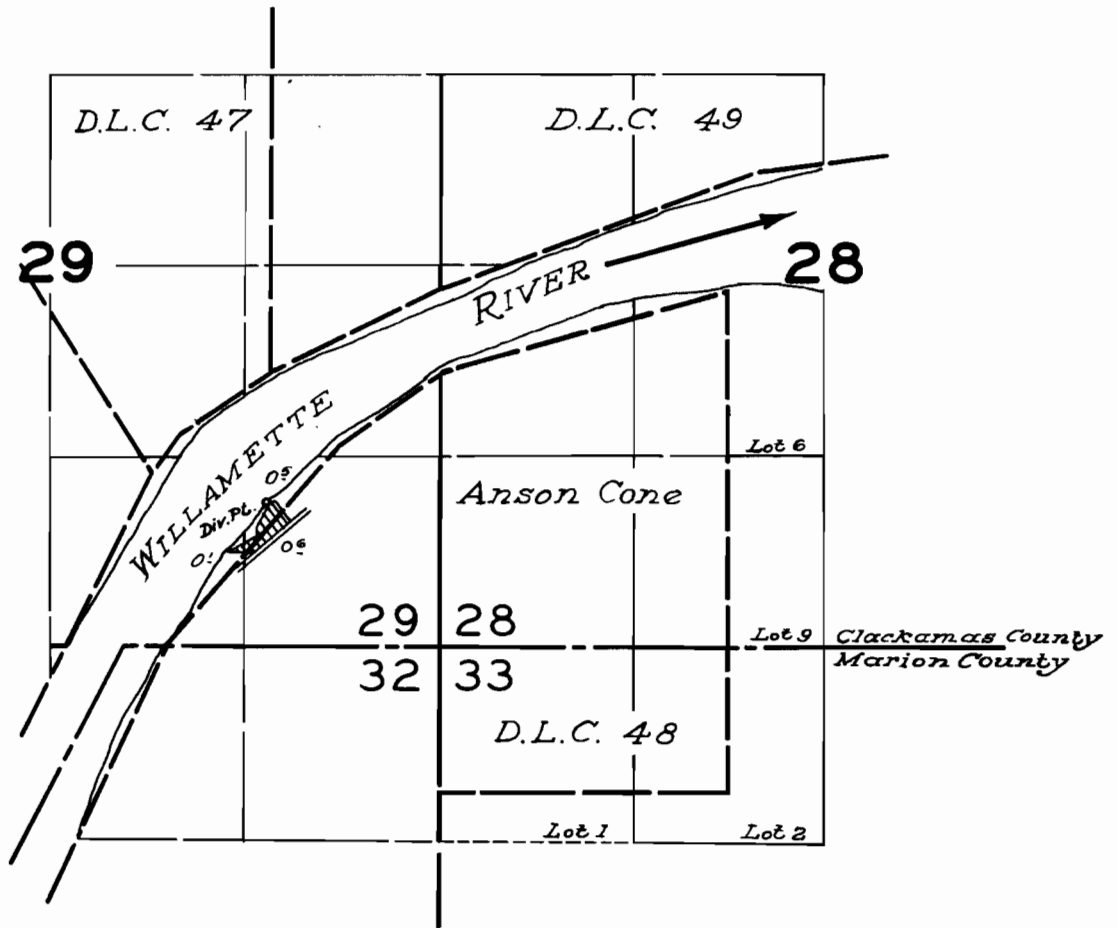

FINAL PROOF SURVEY UNDER

Application No. 30931... Permit No. 24343.
IN NAME OF

JOHN H. BOYD

Surveyed April 25 1960, by *RH Jackson*