


T.3S. R. 3E.W.M.

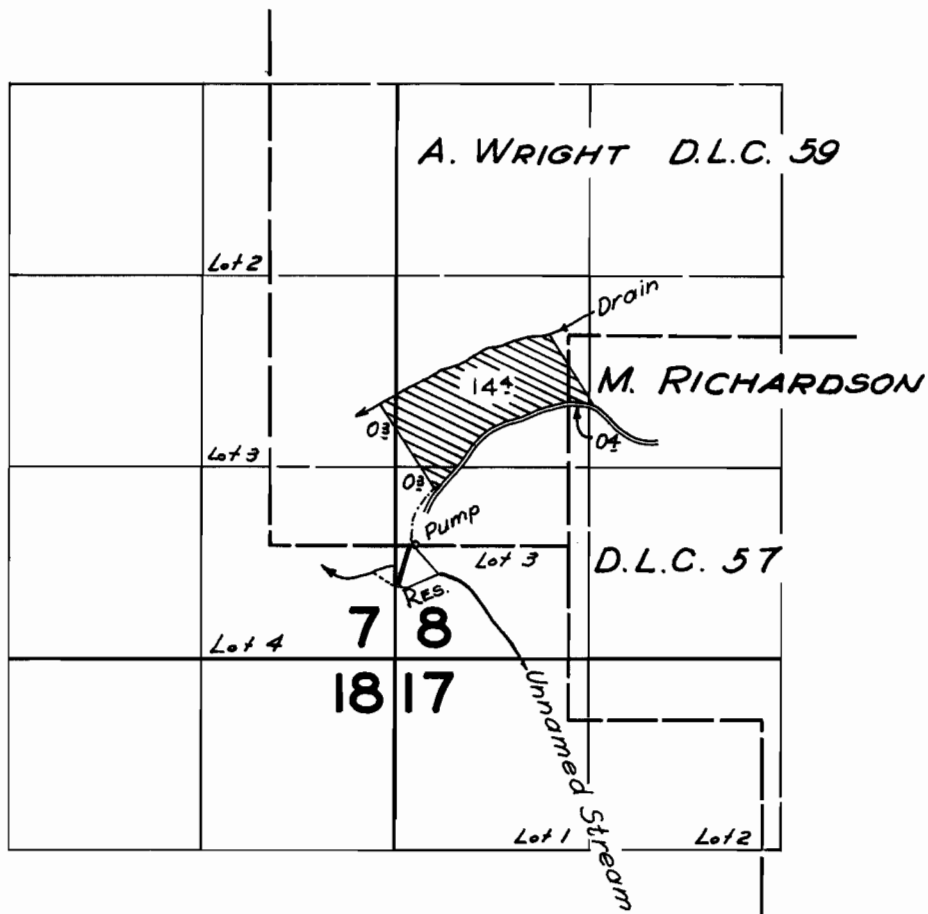

FINAL PROOF SURVEY
UNDER

Application No. R-31803 31804 Permit No. R-2061 25058
IN NAME OF

RICHARD POLEHN

Surveyed 22 April 1960, by R. H. Jackson