


T.3S. R.2E.W.M.

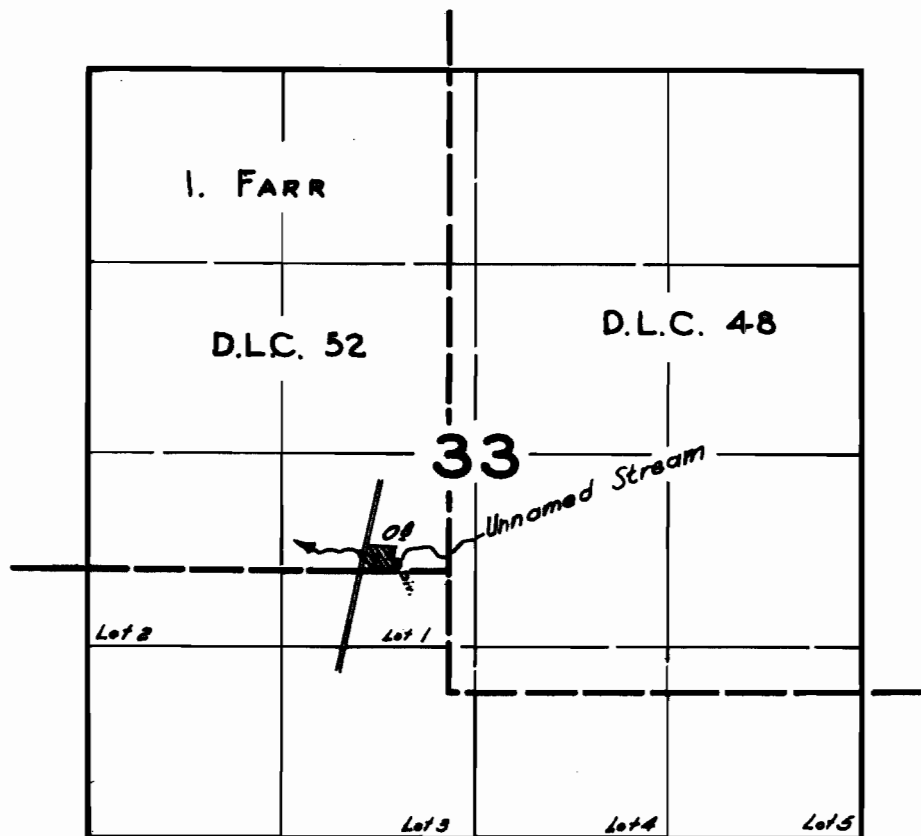

FINAL PROOF SURVEY
UNDER

Application No. 31863 Permit No. 25118....
IN NAME OF

BERNARD R. ROSENAU

Surveyed 21 April 1960, by D. Jackson