
T.4N.R.2W.W.M.

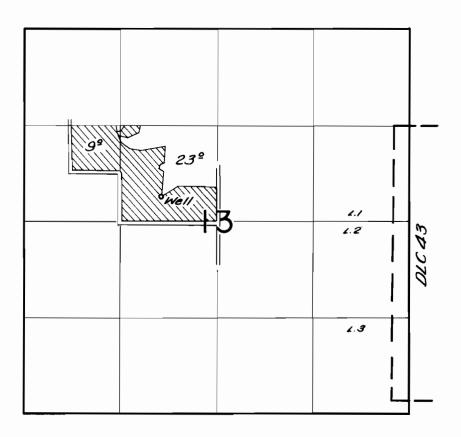

FINAL PROOF SURVEY

Application No. 6-1565. Permit No. 6-1447. IN NAME OF		
PAUL J. DE SHAZER		
Surveyed July 19	1960 hv	C. O Bastols