


T. 7N. R. 2W.W.M.

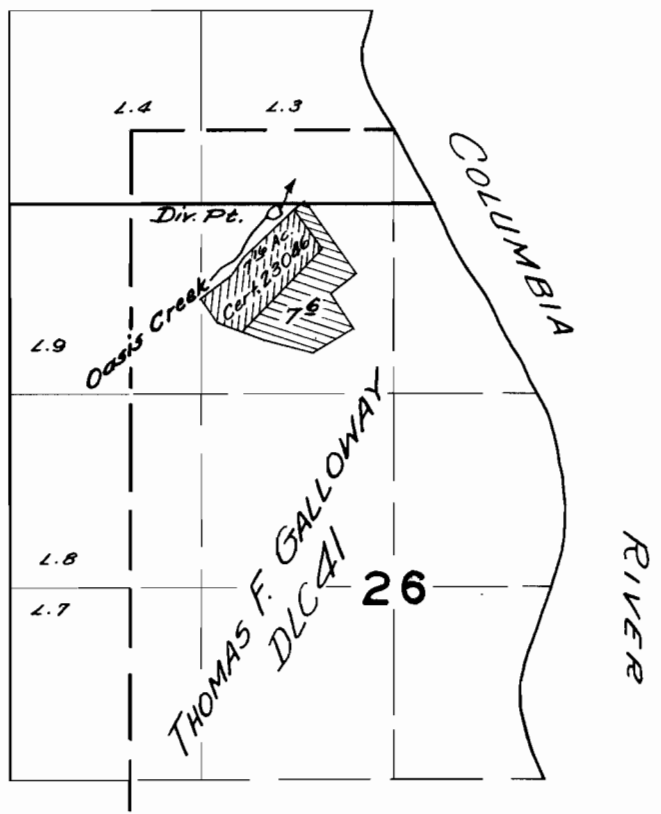

FINAL PROOF SURVEY
UNDER

Application No. 33208 Permit No. 26256
IN NAME OF

.....C.M. Kelly.....

Surveyed July 15, 1960, by C.D. Bartels