T. 6 N. R. 2 W.W.M.

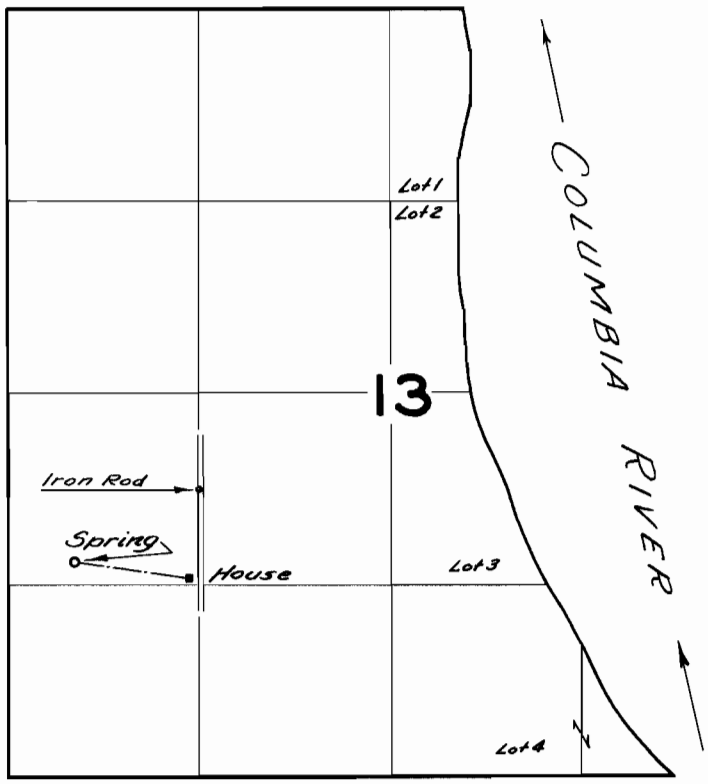

FINAL PROOF SURVEY
UNDER

Application No. 33888 Permit No. 26706
IN NAME OF

John W. & Betty Nesbitt

Surveyed July 15 1960, by C.O. Bartels

1960-X