


T.26S.R.13W.W.M.

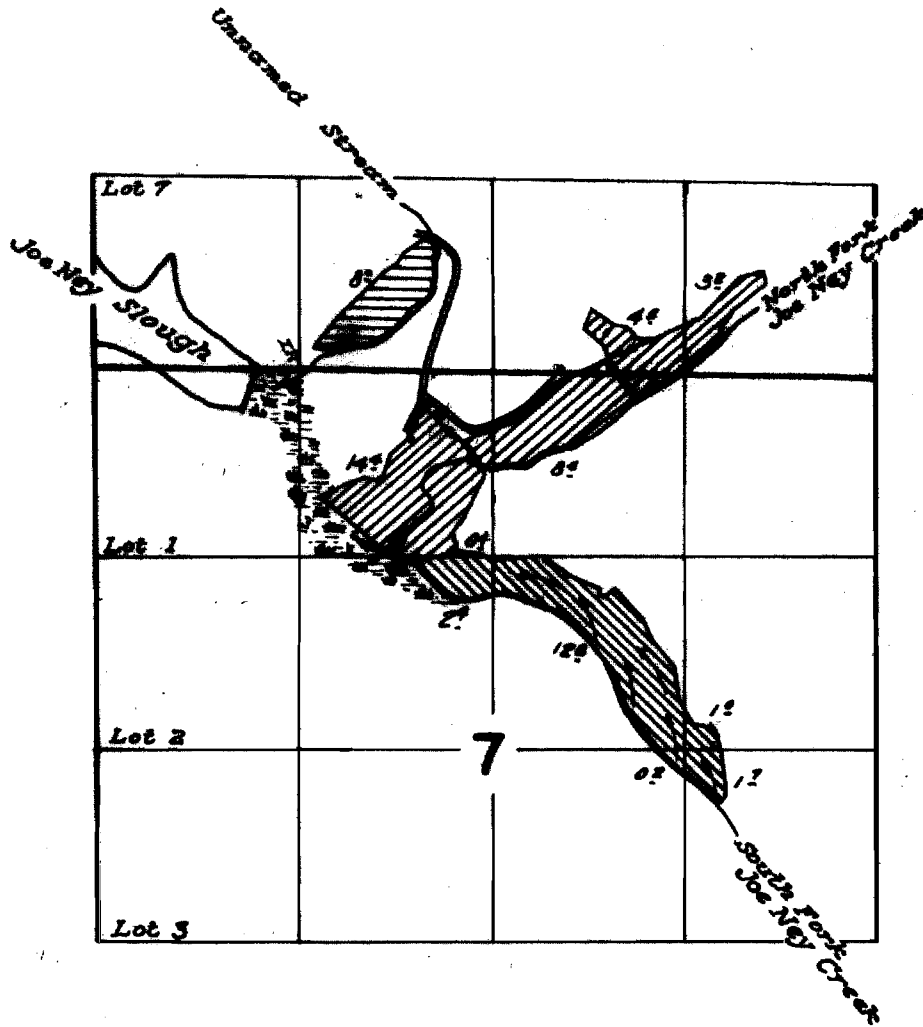

**FINAL PROOF SURVEY**  
UNDER

Application No. 214.9.2... Permit No. 16857....  
IN NAME OF

*EDWARD L. SKOG, J. ELMORE & ALPHA PEDERSON*

Surveyed June 23 1960, by *R. Jackson*