


T.29S. R.14W.W.M.

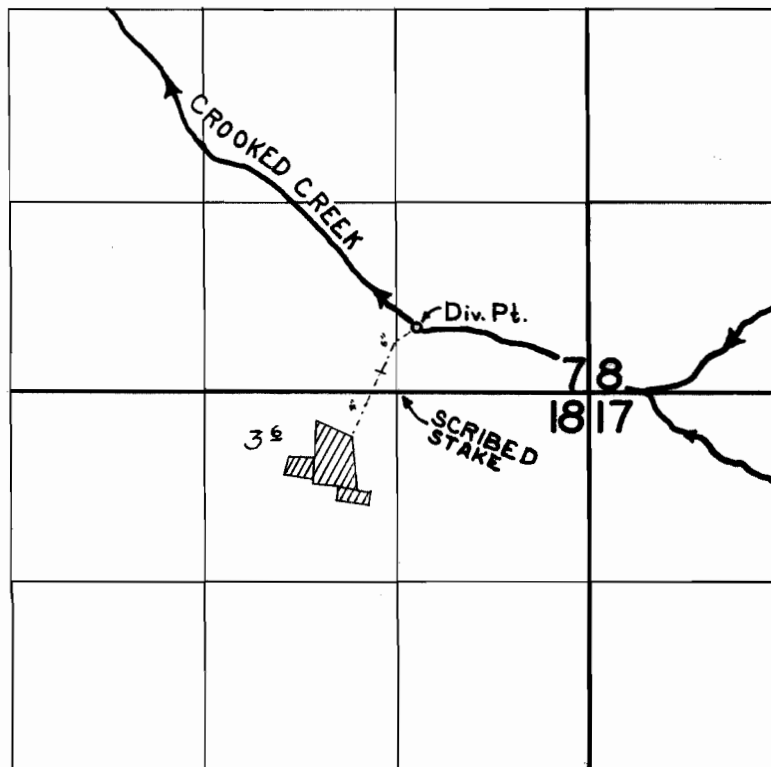

FINAL PROOF SURVEY
UNDER

Application No. 29269... Permit No. 23017....
IN NAME OF

.....GERTRUDE PEARL TUCKER.....

Surveyed JUNE 16 1960, by M. BISH.....