


T.28S.R.13W.W.M.

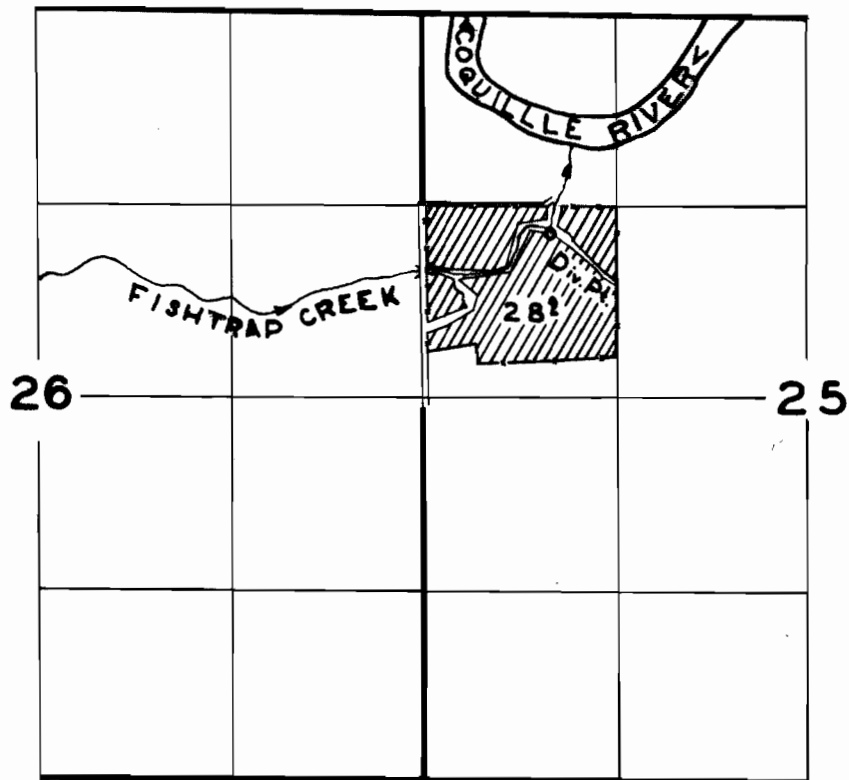

FINAL PROOF SURVEY
UNDER

Application No. 29706... Permit No. 23388...
IN NAME OF

.....ALFRED E. PLAEP.....

Surveyed JUNE 13 1960, by M. BISH.....