


T.28S.R.12W.W.M.

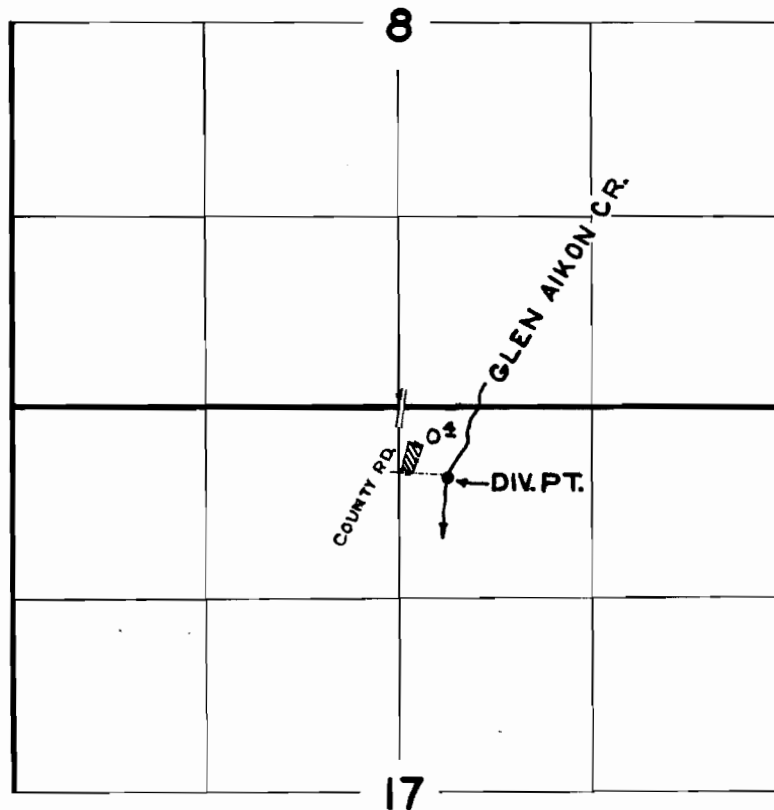

FINAL PROOF SURVEY
UNDER

Application No. 29708 Permit No. 23389
IN NAME OF

J.C. GARDNER

Surveyed JUNE 13 1960, by M. BISH